


T.19S.R.1W.W.M.

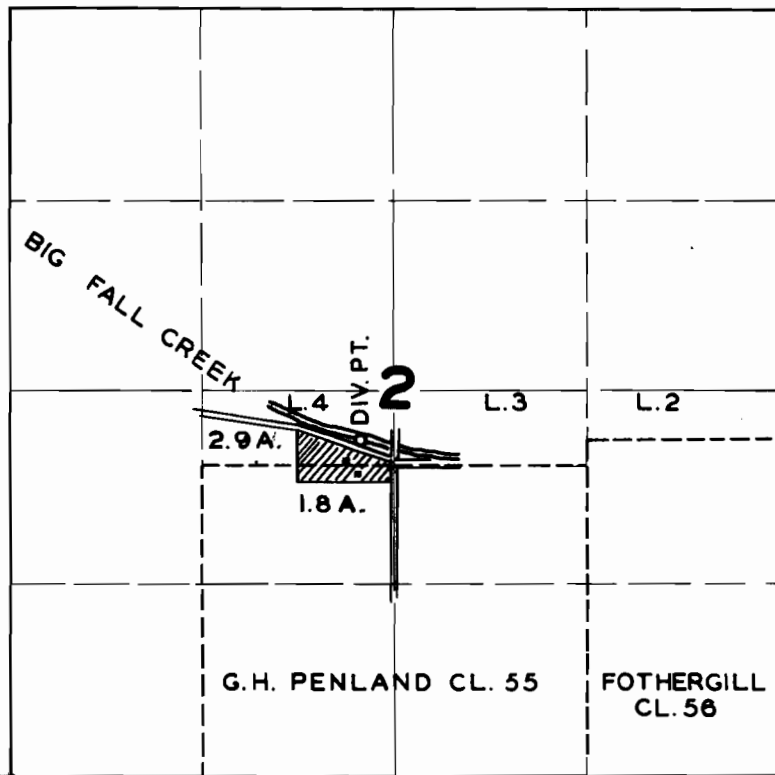

FINAL PROOF SURVEY
UNDER

Application No. **22568** Permit No. **17763**
IN NAME OF

GEORGE H. & AGNES M. WILSON

Surveyed **MAY 31, 1949**, by **H.L. COFFMAN**.