


T. 8S. R. 4W. W.M.

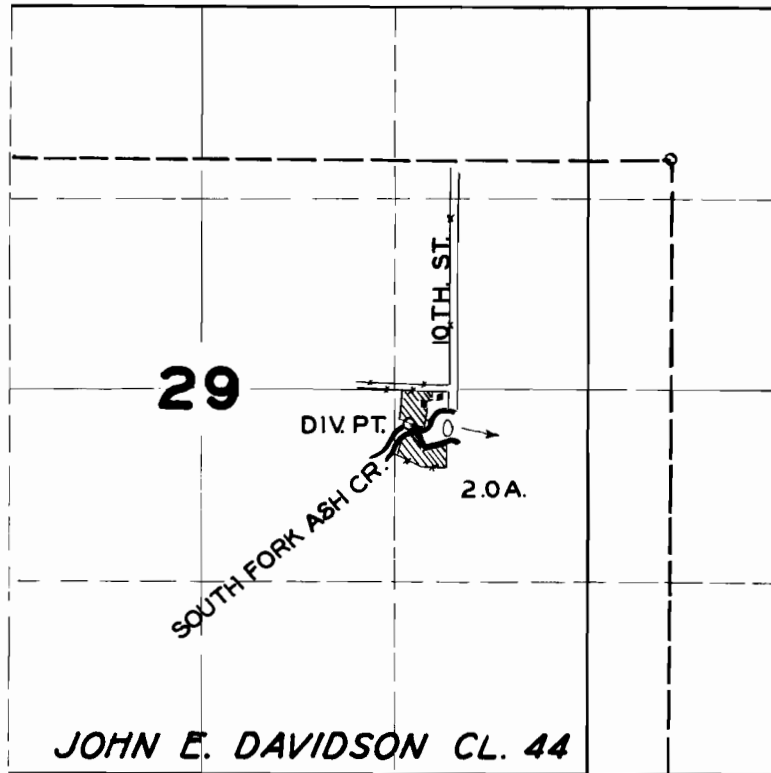

FINAL PROOF SURVEY

UNDER

Application No. **22716** . Permit No. **17851** .

IN NAME OF

FRED H. KELLEY

Surveyed APR. 17 1950 , by H.L. COFFMAN.