


T. 8S. R. 4W. W. M.

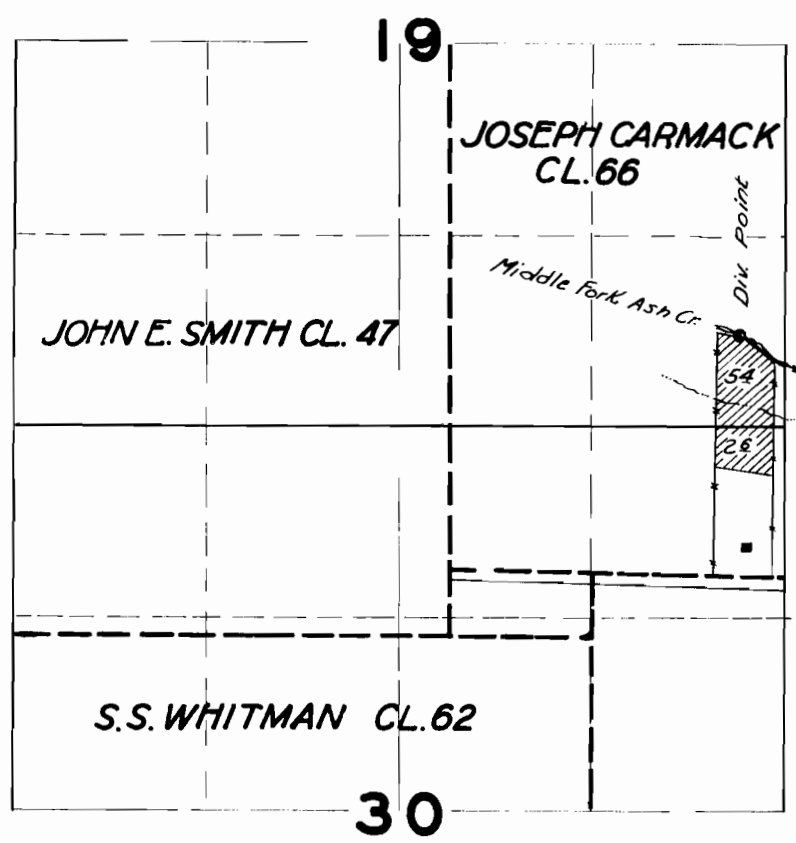

FINAL PROOF SURVEY

UNDER

Application No. 22820. Permit No. 17961.....

IN NAME OF

FRED F. NOYES.....

Surveyed APR. 6. 1950., by H.L. COFFMAN.