


T. 4 S. R. 3 & 4 W. W. M.

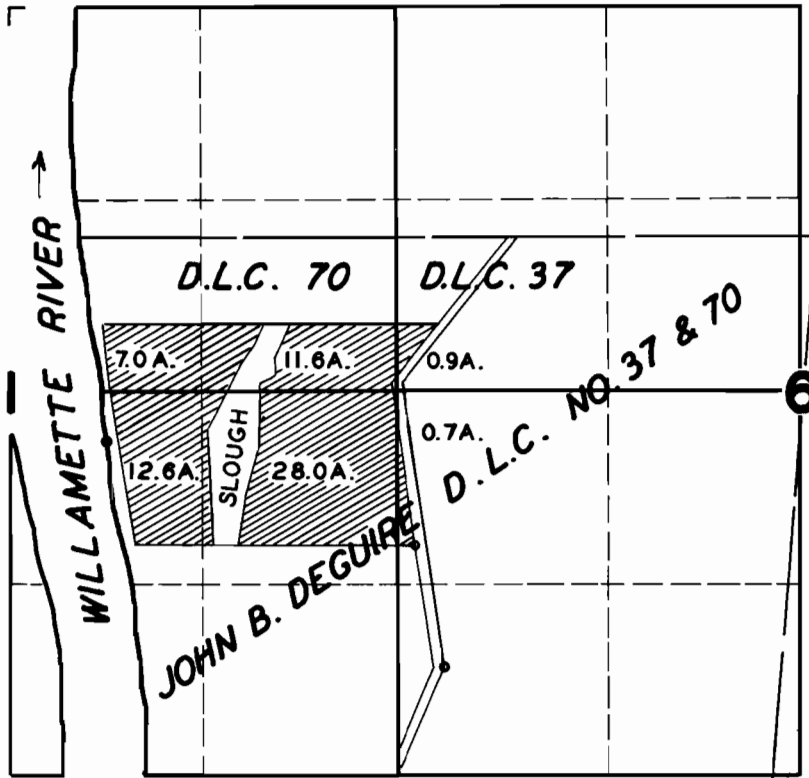

**FINAL PROOF SURVEY**

UNDER

Application No. 22886 Permit No. 18054

IN NAME OF

BURNELL OLSON

Surveyed MAR. 22 1949, by JAS. E. BUNNELL