

C1947

907


18 17 16 15 14

19 20 21 22 23

Application No. 1849
Permit No. 907

Township 18 S
R 26 E W.M.

30 29 28 27 26

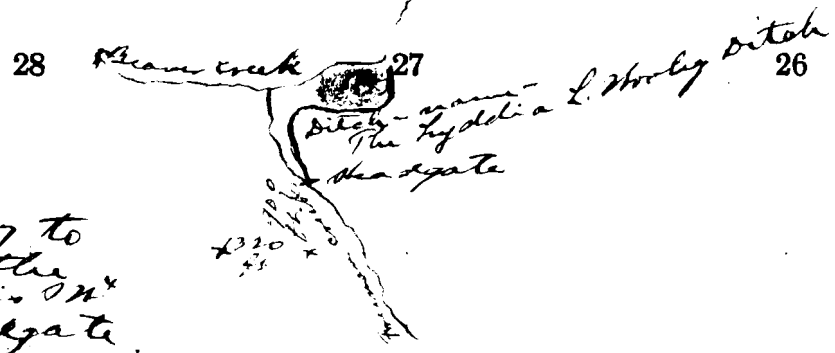

Note - Distance from NW corner of Sec. 27 to SE corner of the NW 1/4 is 1320 feet. The distance along the east side of this NW 1/4 to point of diversion and headgate located on Pine Creek, from the said SE corner of said NW 1/4 is 900 feet. This line runs the first distance east, then north to headgate, from said NW corner of section 27.

Map of
The Lyddia L. Wooley di
Igne, Oregon.