


# T. 2 S. R. 2 E. W.M.

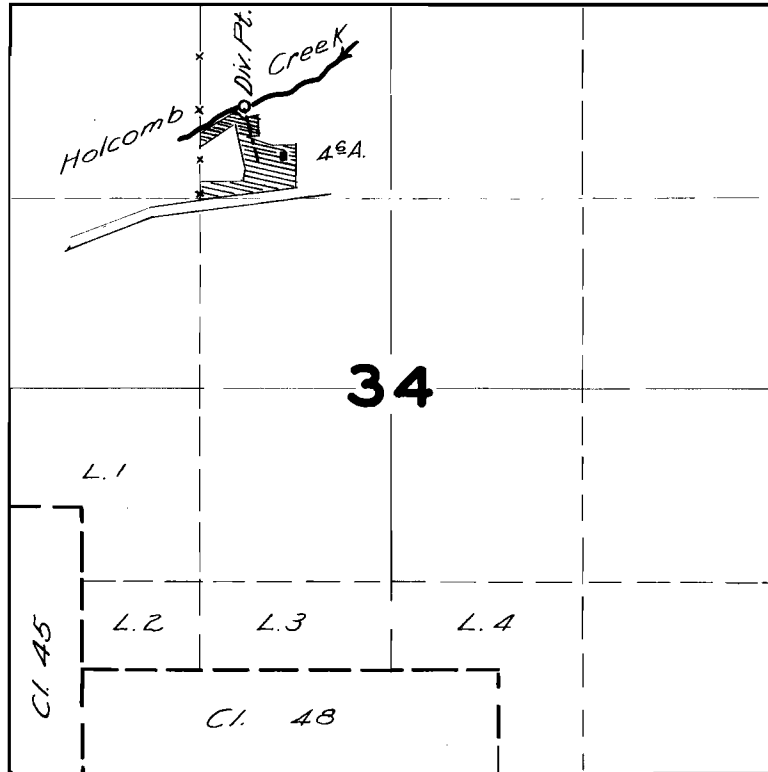

## FINAL PROOF SURVEY

UNDER

Application No. 23146. Permit No. 18236.

IN NAME OF

LEO J. GASSER & STELLA S. GASSER

Surveyed APR. 27, 1950., by H.L. COFFMAN.