


T. 4S. R. 3 E. W.M.

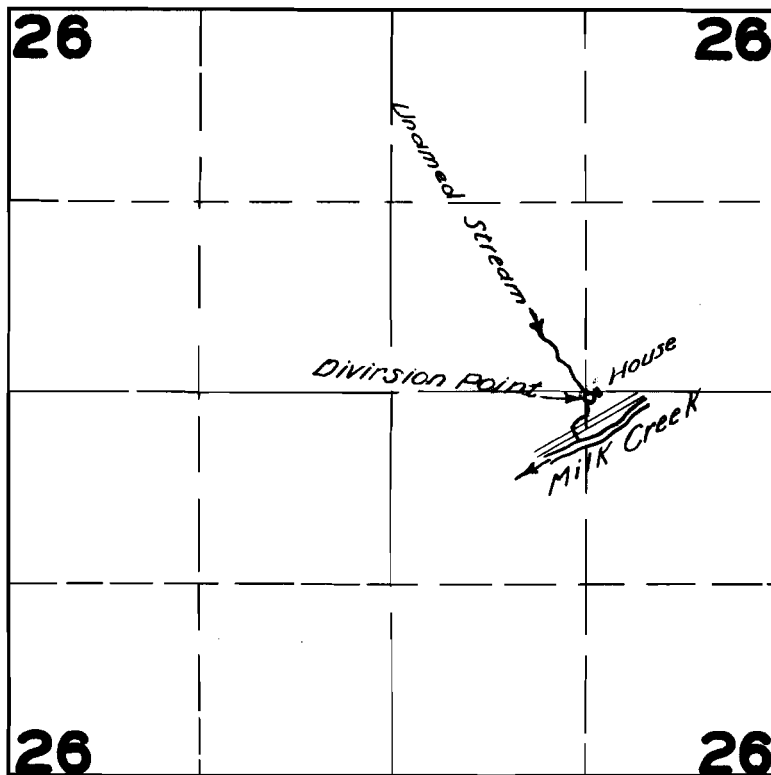

FINAL PROOF SURVEY
UNDER

Application No. **21560**. Permit No. **18548**.
IN NAME OF

.....**MRS. LAURA M. KOLLINS**.....

Surveyed **APR. 20 1950**., by **H.L. COFFMAN**.