


# T. 7S. R. 39E.W.M.

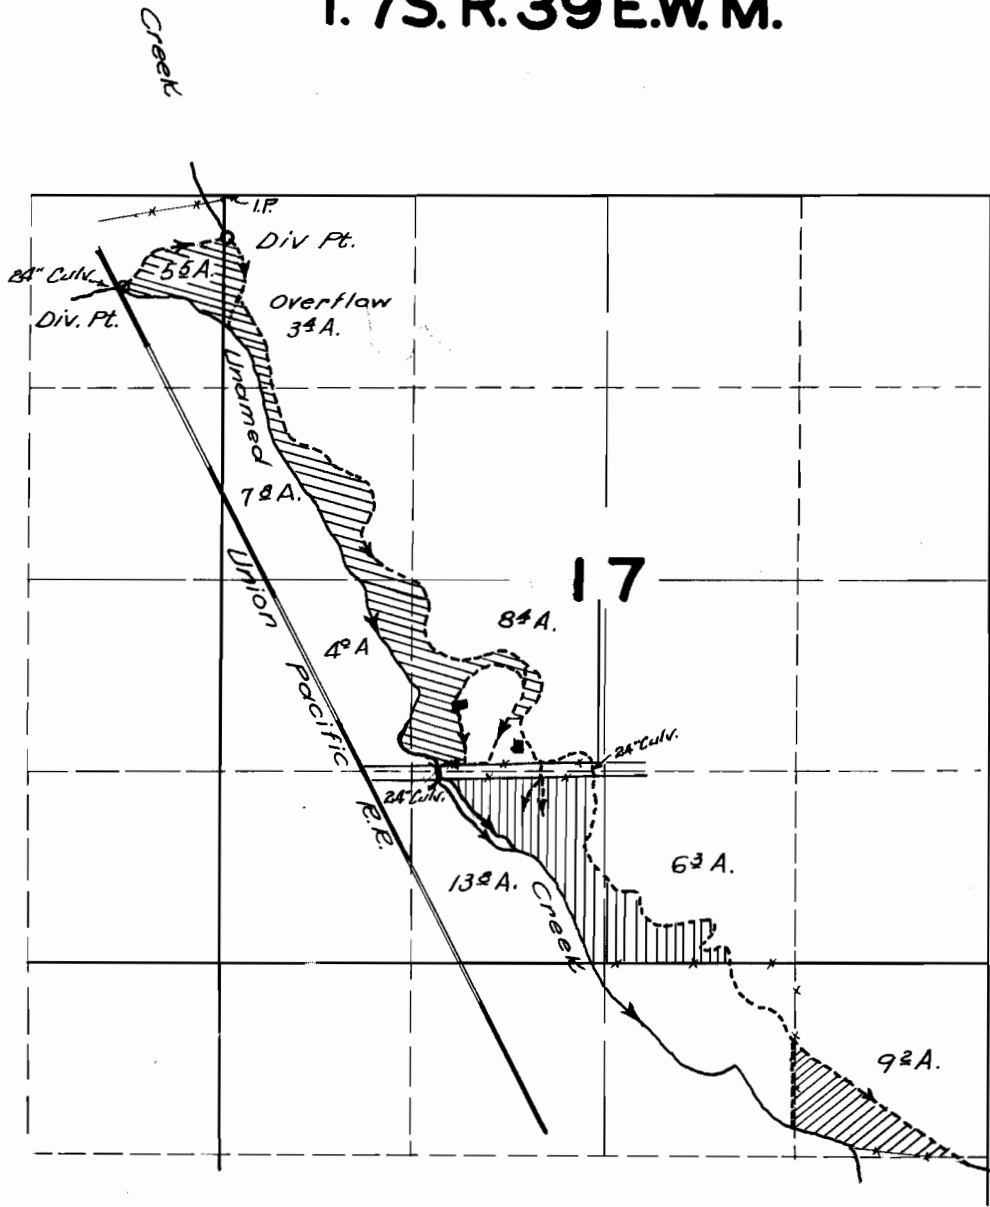

## FINAL PROOF SURVEY

UNDER

Application No. 23385 Permit No. 18460

IN NAME OF

C.H. MARSHALL, E.O. Mc GOLDRICK & W.A. DAUGHERTY

Surveyed NOV. 17, 1949, by H.L. COFFMAN.