


**T. 6S. R. 2W. W. M.**

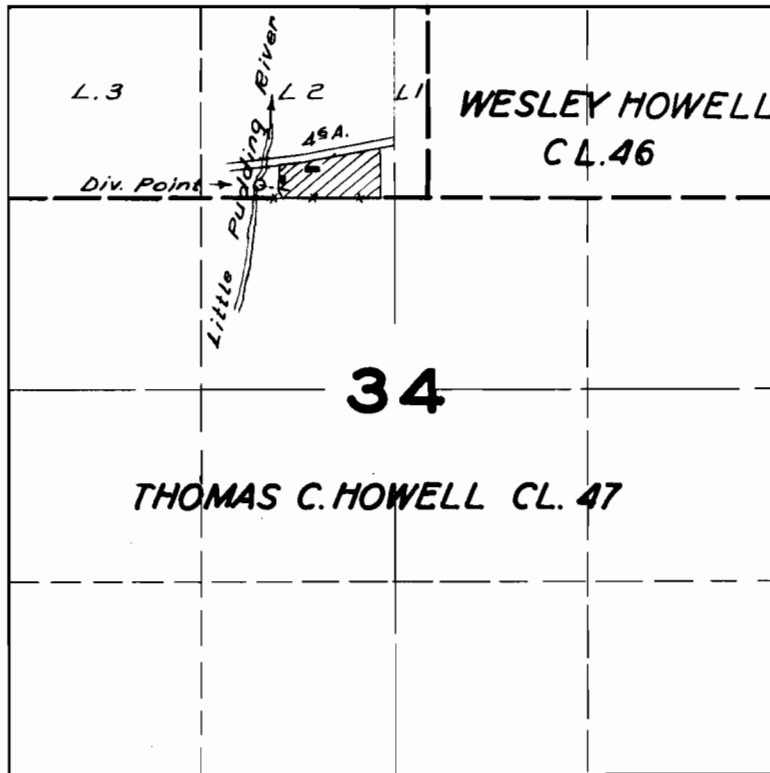

**FINAL PROOF SURVEY**  
UNDER

Application No. 23547 Permit No. 18593  
IN NAME OF

A. FOREST SIMMONS

Surveyed NOV. 10. 1949. by H.L. COFFMAN.