


**T. 7S. R 6W. W M.**

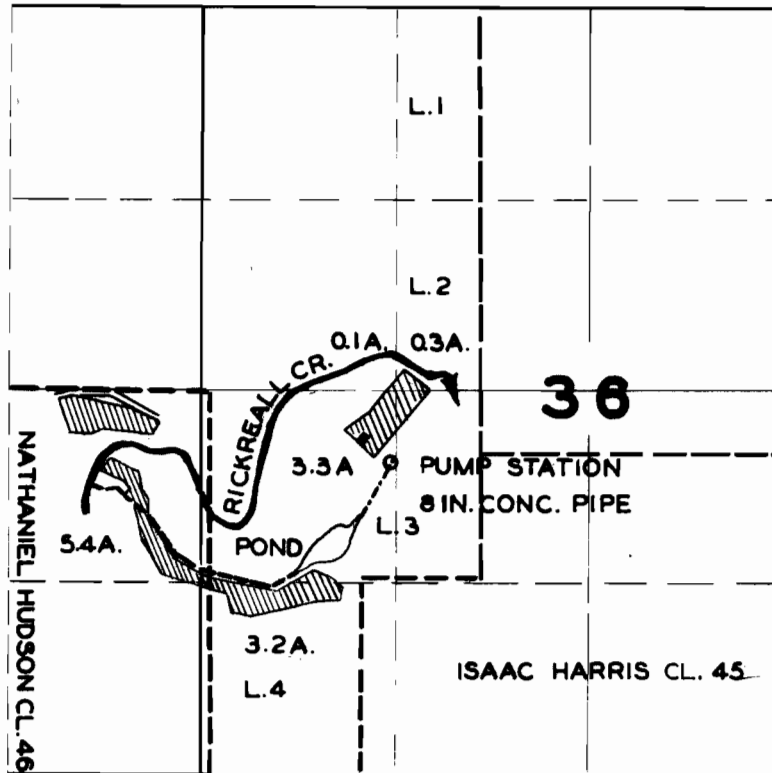

**FINAL PROOF SURVEY**  
UNDER

Application No. **23855** Permit No. **18789**.....  
IN NAME OF

...**WILLIAM MAURICE DALTON**.....

Surveyed **APR. 11, 1950.**, by **H.L. COFFMAN**..