


T.16S.R.5W.W.M.

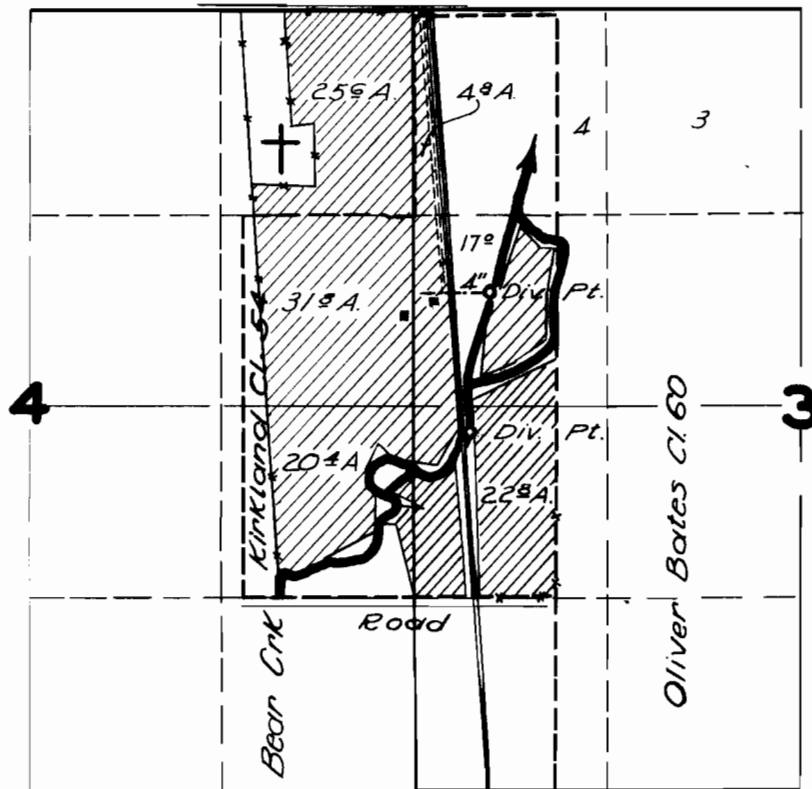

FINAL PROOF SURVEY

UNDER

Application No. 20557 Permit No. 16057

IN NAME OF

TIM JONES

Surveyed MAY 12 19... by H.L. COFFMAN