


T.29S.R.13W.W.M.

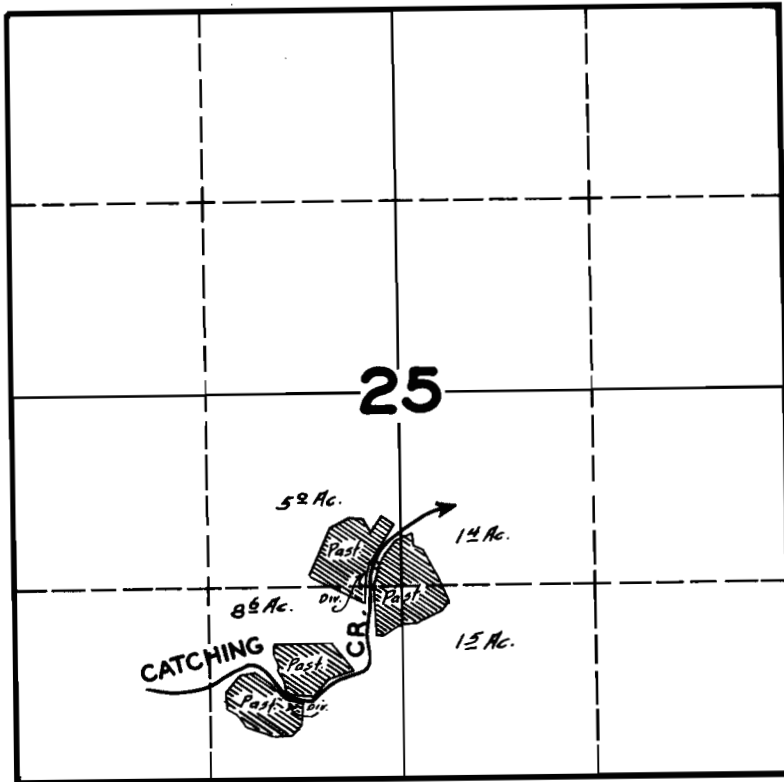

**FINAL PROOF SURVEY**  
UNDER

Application No. 19682 Permit No. 15261

IN NAME OF

JOHN FABRY

Surveyed AUG. 19 1947, by JAS. E. BUNNELL