


T.2S.R.9W.W.M.

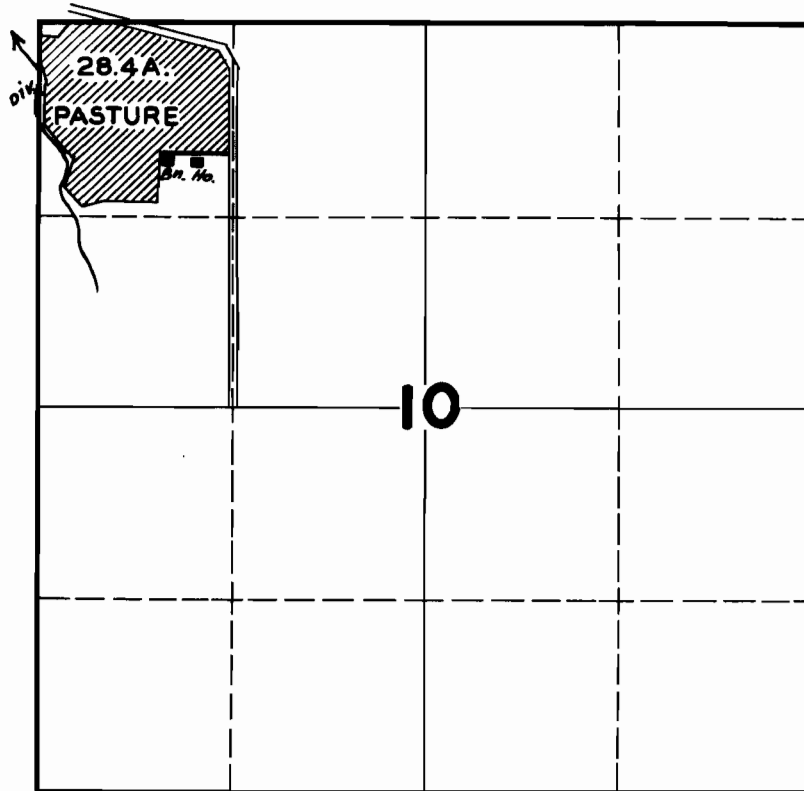

FINAL PROOF SURVEY

UNDER

Application No. 20528 Permit No. 16028

IN NAME OF

WALTER SCHOENE & ALBERT VERRAN

Surveyed SEP. 14 1948, by JAS. E. BUNNELL