


**T.5S.R.5W.W.M.**

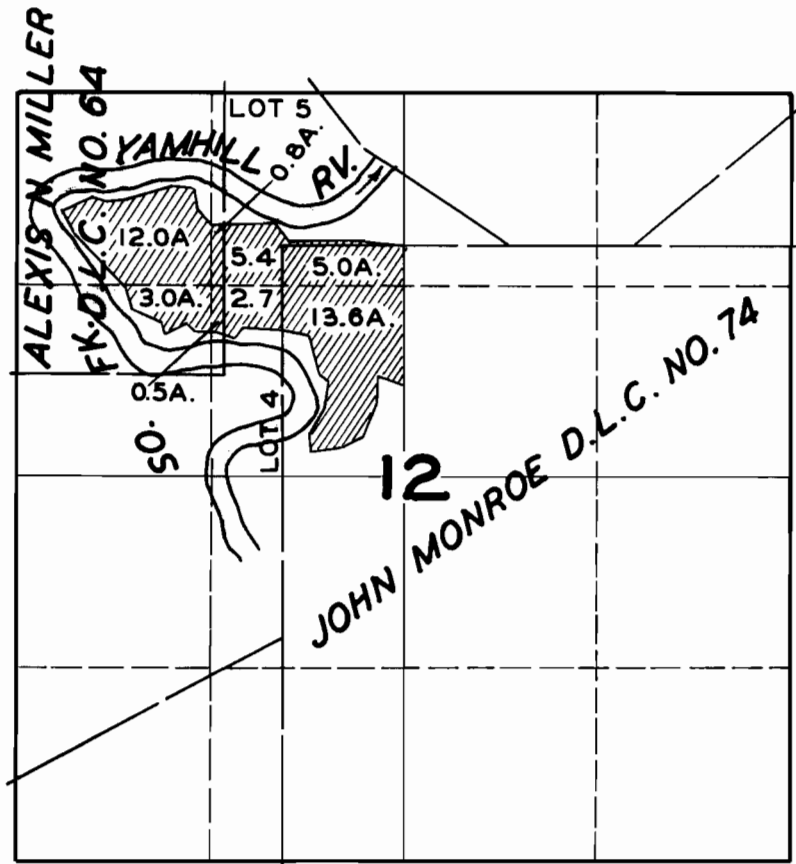

**FINAL PROOF SURVEY**

UNDER

Application No. **23026** Permit No. **18197**.....

IN NAME OF

**CHESTER L. MULKEY**.....

Surveyed **AUG. 20 1948** by **JAS. E. BUNNELL**