


T.17S.R.6W.W.M.

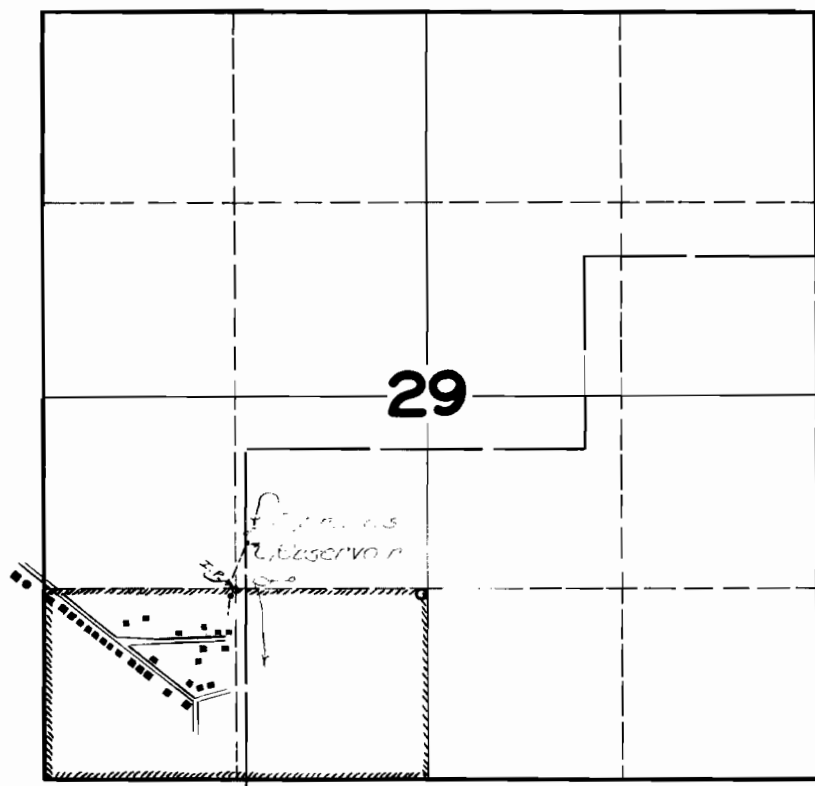

**FINAL PROOF SURVEY
UNDER**

Application No. 21041 Permit No. 16486

**IN NAME OF
EDWIN A. WILDER**

Surveyed AUG. 5, 1946, by

[Signature]