


# T. 5 S. R. 1 E. W.M.

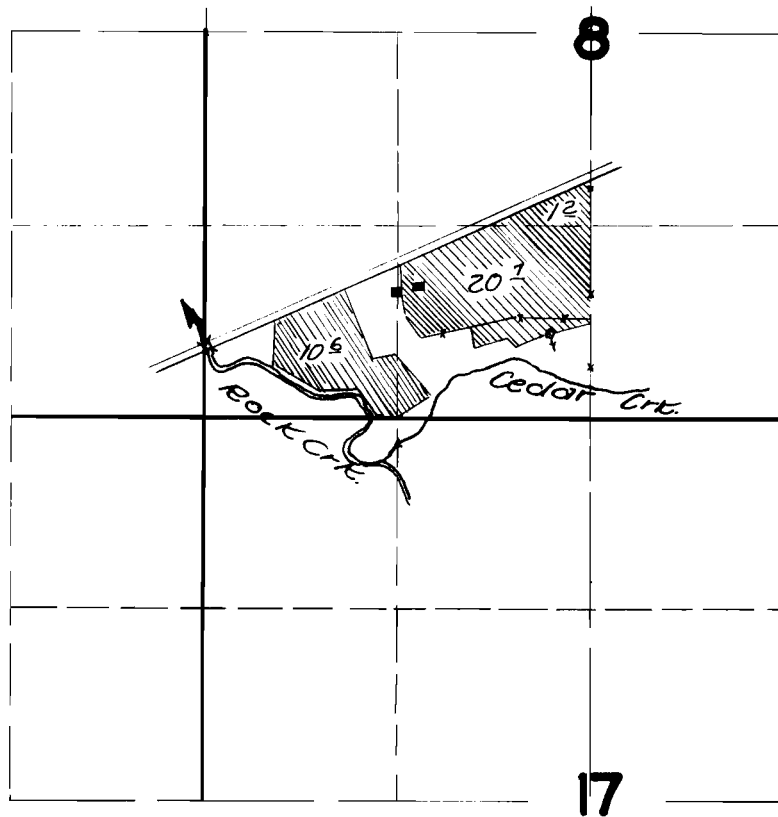

## FINAL PROOF SURVEY

UNDER

Application No **17407** ... Permit No. **13105** ...  
IN NAME OF

**JOE BURDEN**

Surveyed **MAY 12** 1949, by **H.L. COFFMAN**