


T.2S.R.2E.W.M.

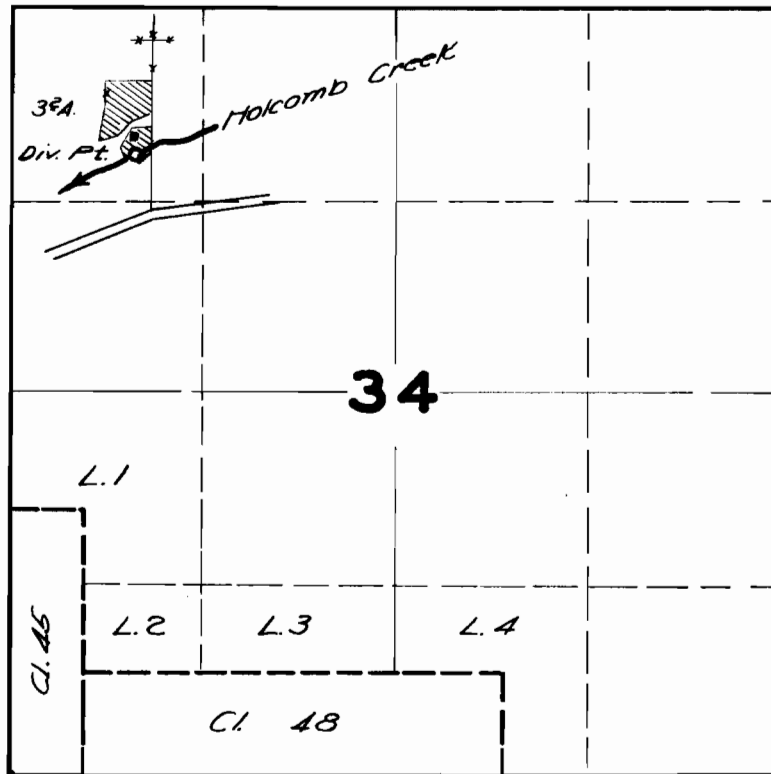

FINAL PROOF SURVEY
UNDER

Application No. **22828** Permit No. **17962**
IN NAME OF

.....**PAUL SHIGLEY**.....

Surveyed APR. 27. 1950., by H.L. COFFMAN.