


T. 1S. R. 3W. W.M.

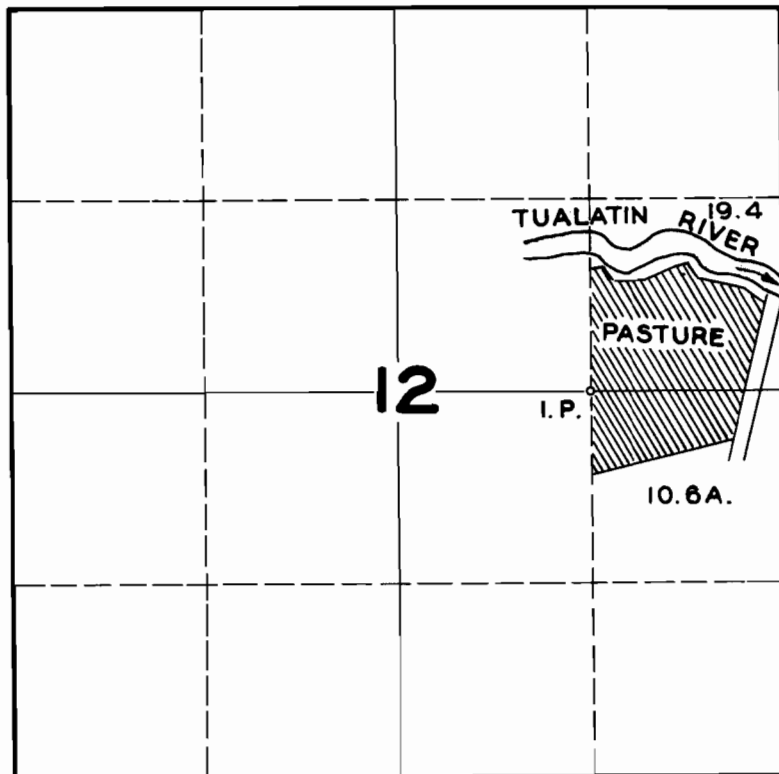

FINAL PROOF SURVEY UNDER

Application No. 19768 Permit No. 15352
IN NAME OF

SAM HULIT

Surveyed JULY 15 1947, by JAS. E. BUNNELL