


T. 7S. R. 39E. W.M.

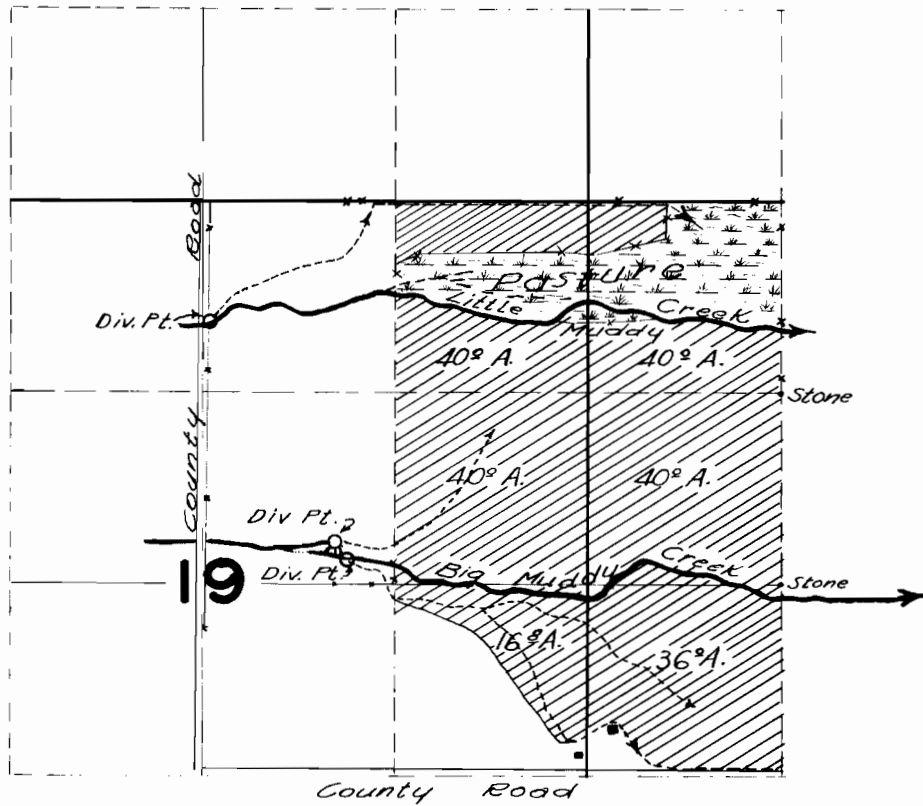

FINAL PROOF SURVEY

UNDER

Application No. 13870 . Permit No. 18316.

IN NAME OF

JOHN K. PROEBSTEL

Surveyed NOV. 22 1949, by H.L. COFFMAN