


T. 5 S. R. 3 E. W. M.

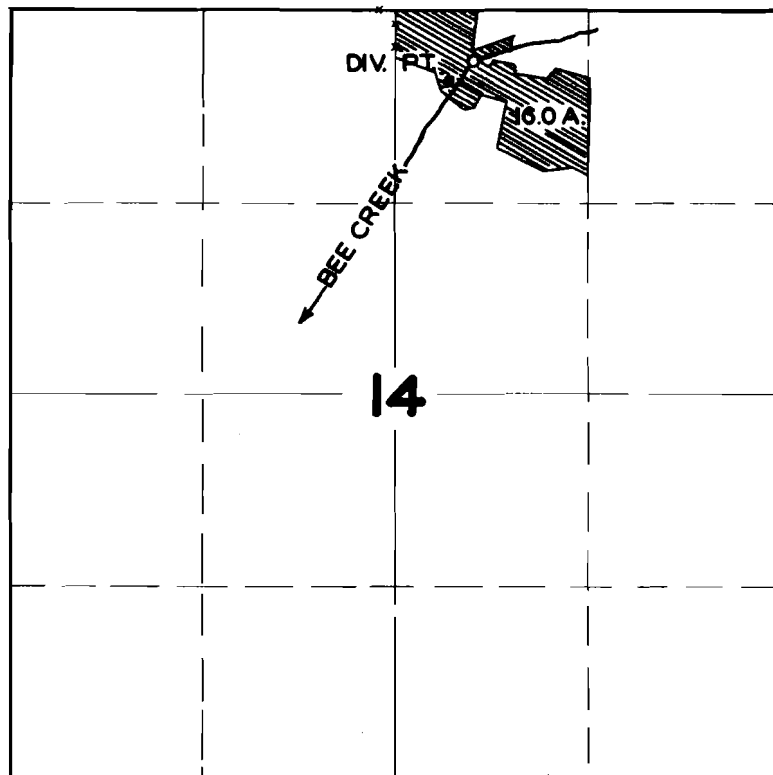

FINAL PROOF SURVEY
UNDER

Application No. 21533 Permit No. 16887
IN NAME OF

ROBERT LITTLE

Surveyed APR. 21 1950, by H.L. COFFMAN.