


T. 4 S. R. 1 E. W.M.

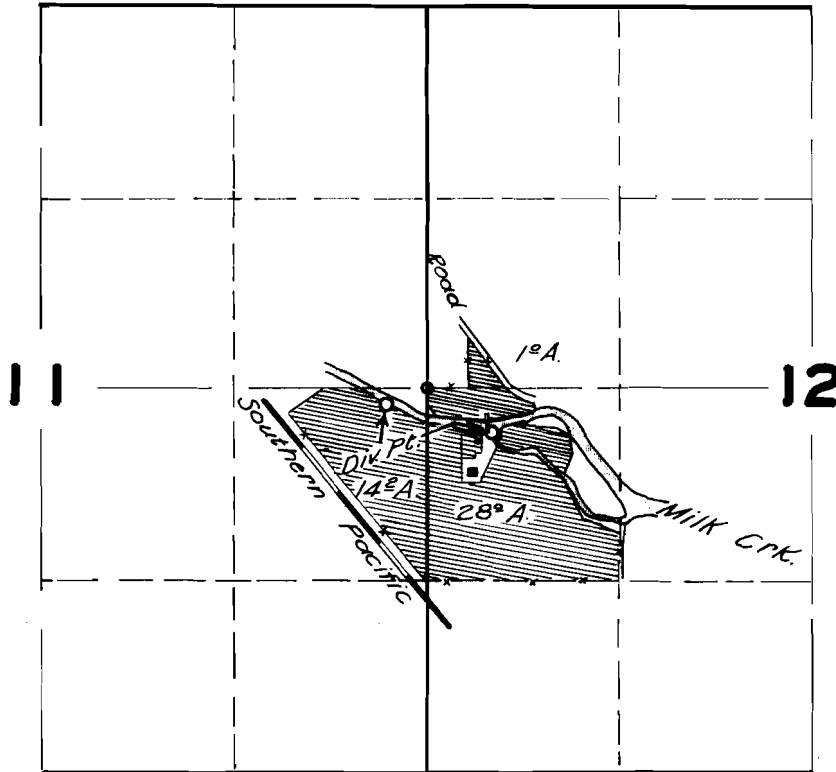

FINAL PROOF SURVEY
UNDER

Application No. 23060 Permit No. 18202
IN NAME OF

.....**FRED H. SCALLON**.....

Surveyed APR. 25. 1950., by H.L. COFFMAN