


T.17S.R.3E.W.M.

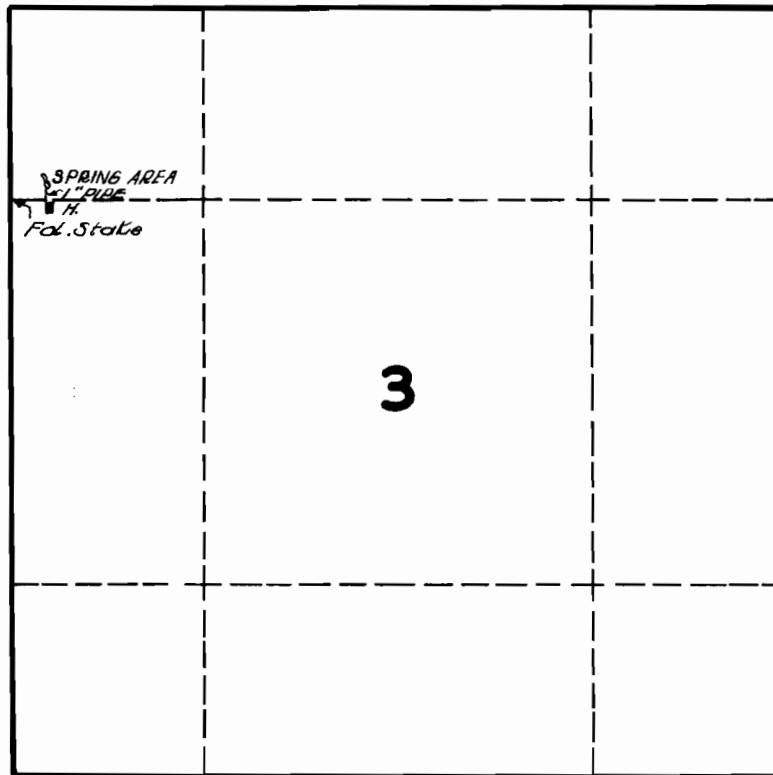

FINAL PROOF SURVEY
UNDER

Application No. 19397 Permit No. 14982

IN NAME OF

MRS. RUBE MONTGOMERY

Surveyed JUN. 27 1949, by

[Handwritten signature]