


T. IN. R. 3 E. W. M.

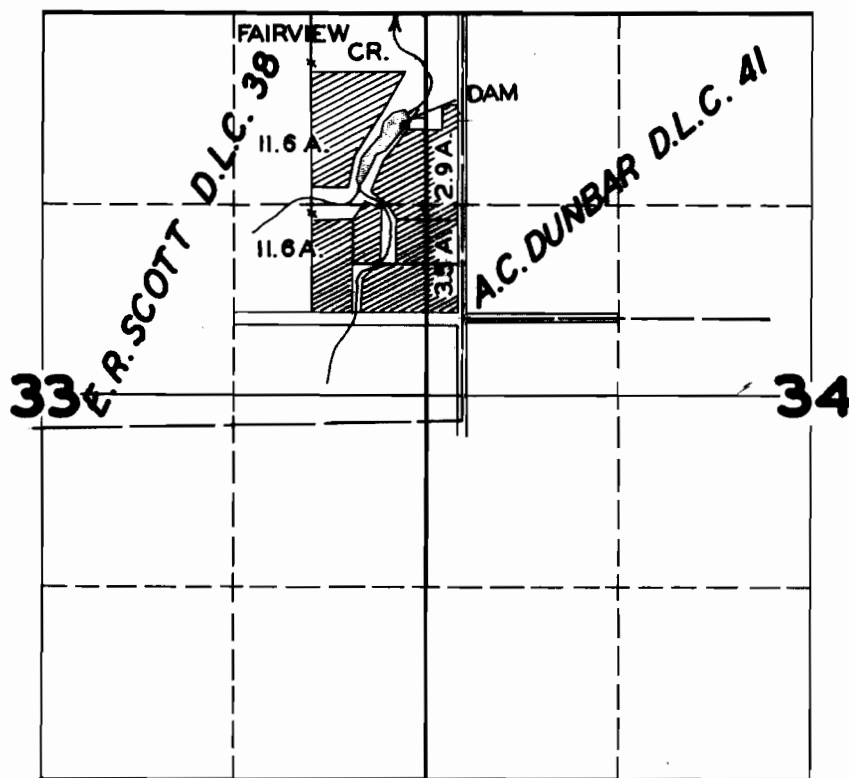

FINAL PROOF SURVEY

UNDER

Application No. **19225**... Permit No. **14814**....

IN NAME OF

C. H. STONE

Surveyed **OCT. 13, 1950**, by **JAS. E. BUNNELL**