


T.2N.R.10E.W.M.

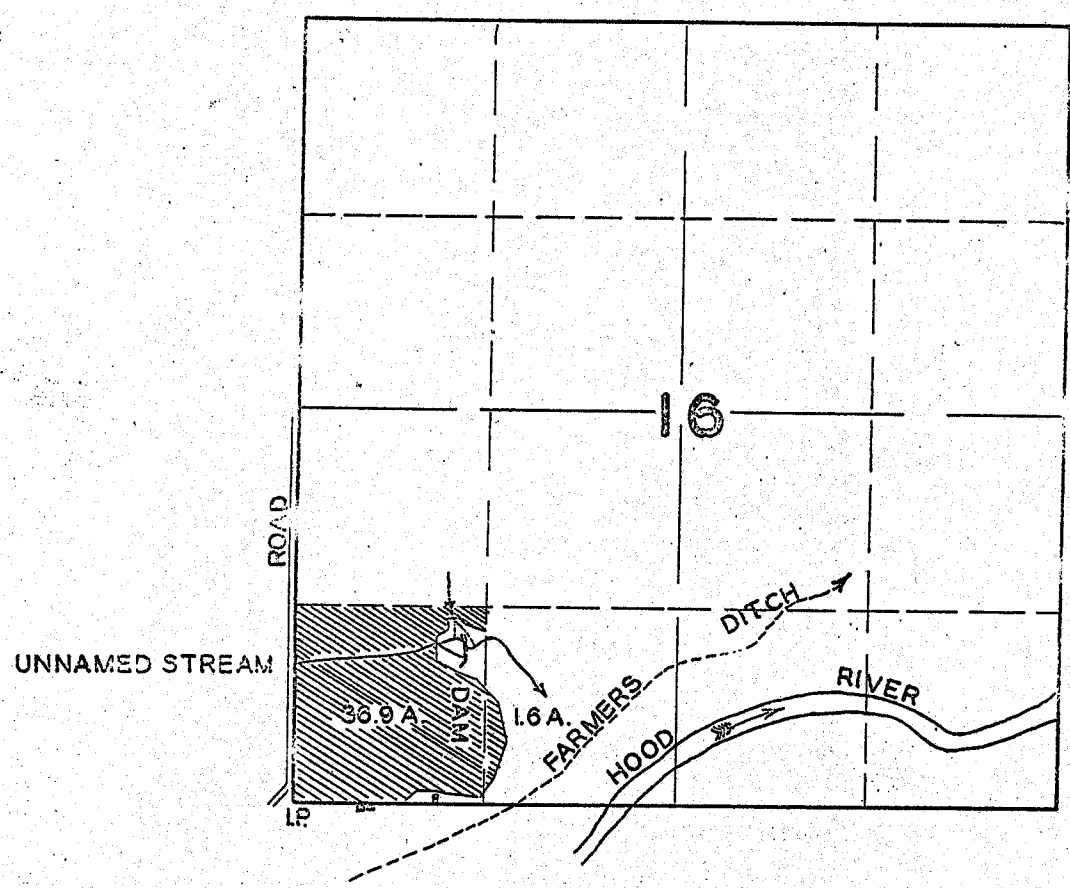

FINAL PROOF SURVEY UNDER

Application No. 19495... Permit No. 15073.
IN NAME OF
OSCAR HUKARI

Surveyed JUNE 16 1950, by H.L. COFFMAN