


T.25S.R.13W.W.M.

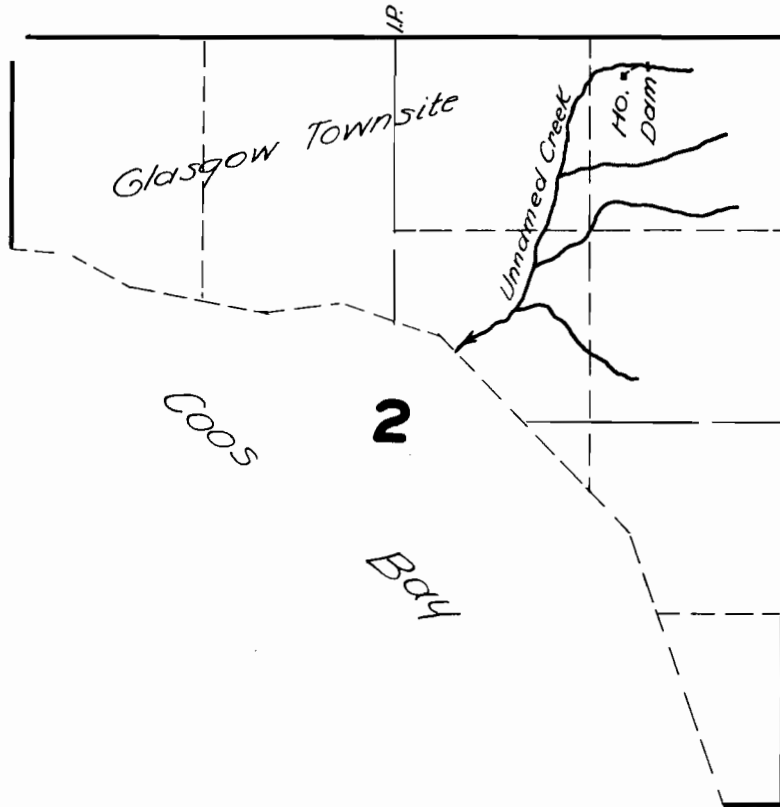

FINAL PROOF SURVEY

UNDER

Application No. **19775**... Permit No. **15358**..

IN NAME OF

.....**T. H. GAULT**.....

Surveyed **JUNE 1**.. 1950., by **H.L. COFFMAN**..