


T.28S.R.14W.W.M.

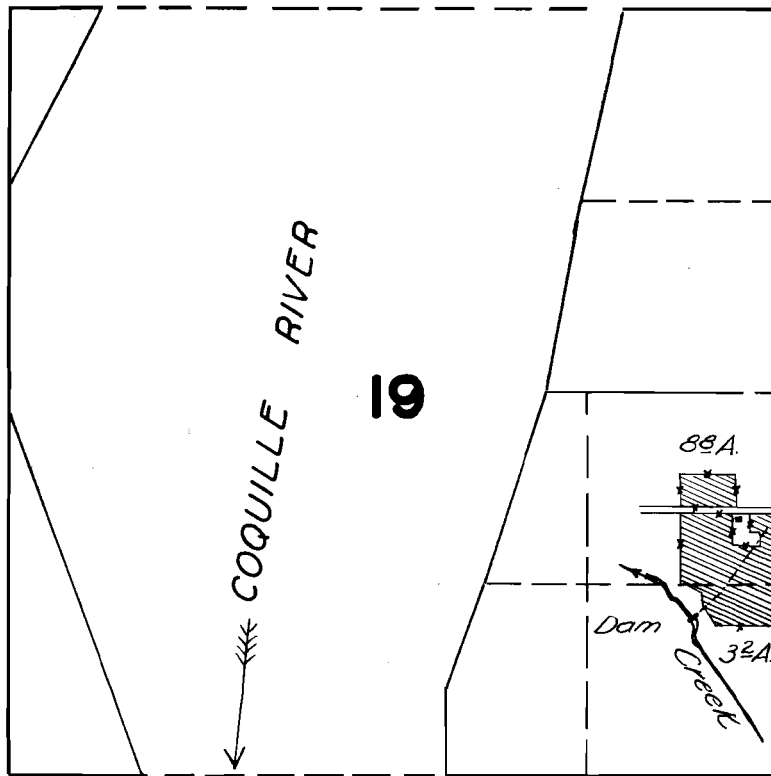

FINAL PROOF SURVEY

UNDER

Application No. **20609** Permit No. **16102**....

IN NAME OF

FRED A. ROBERTSON.....

Surveyed JUNE 2, 1950, by H.L. COFFMAN.