


T.3S.R.12E.W.M.

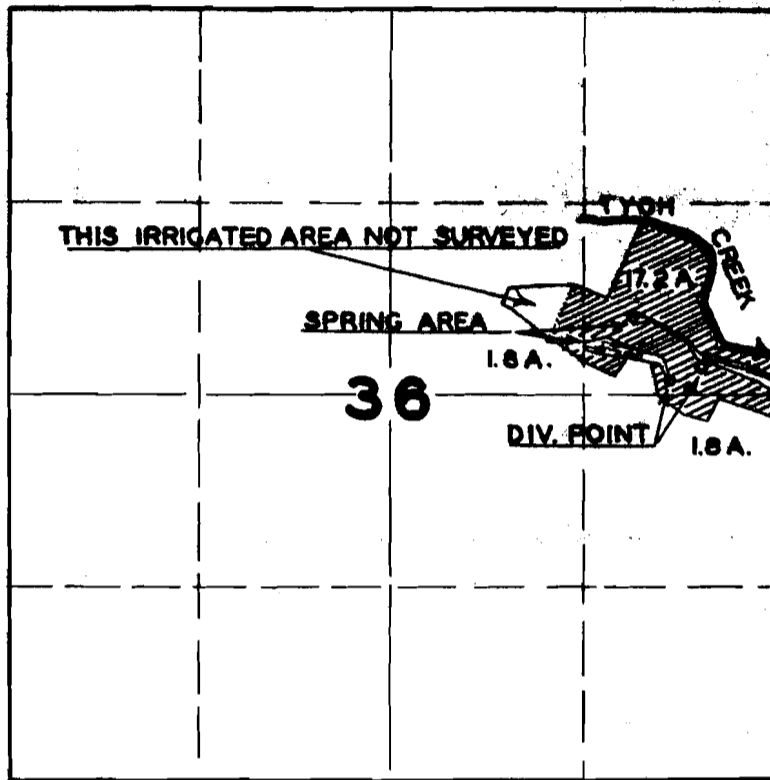

FINAL PROOF SURVEY UNDER

Application No. 20710... Permit No. 16192...
IN NAME OF

..... L. O. WING

Surveyed JULY 12 1950., by H.L. COFFMAN..

16192
1950 D