


SECTION

32  
33

TOWNSHIP 38 S, RANGE 1 E, W. M.

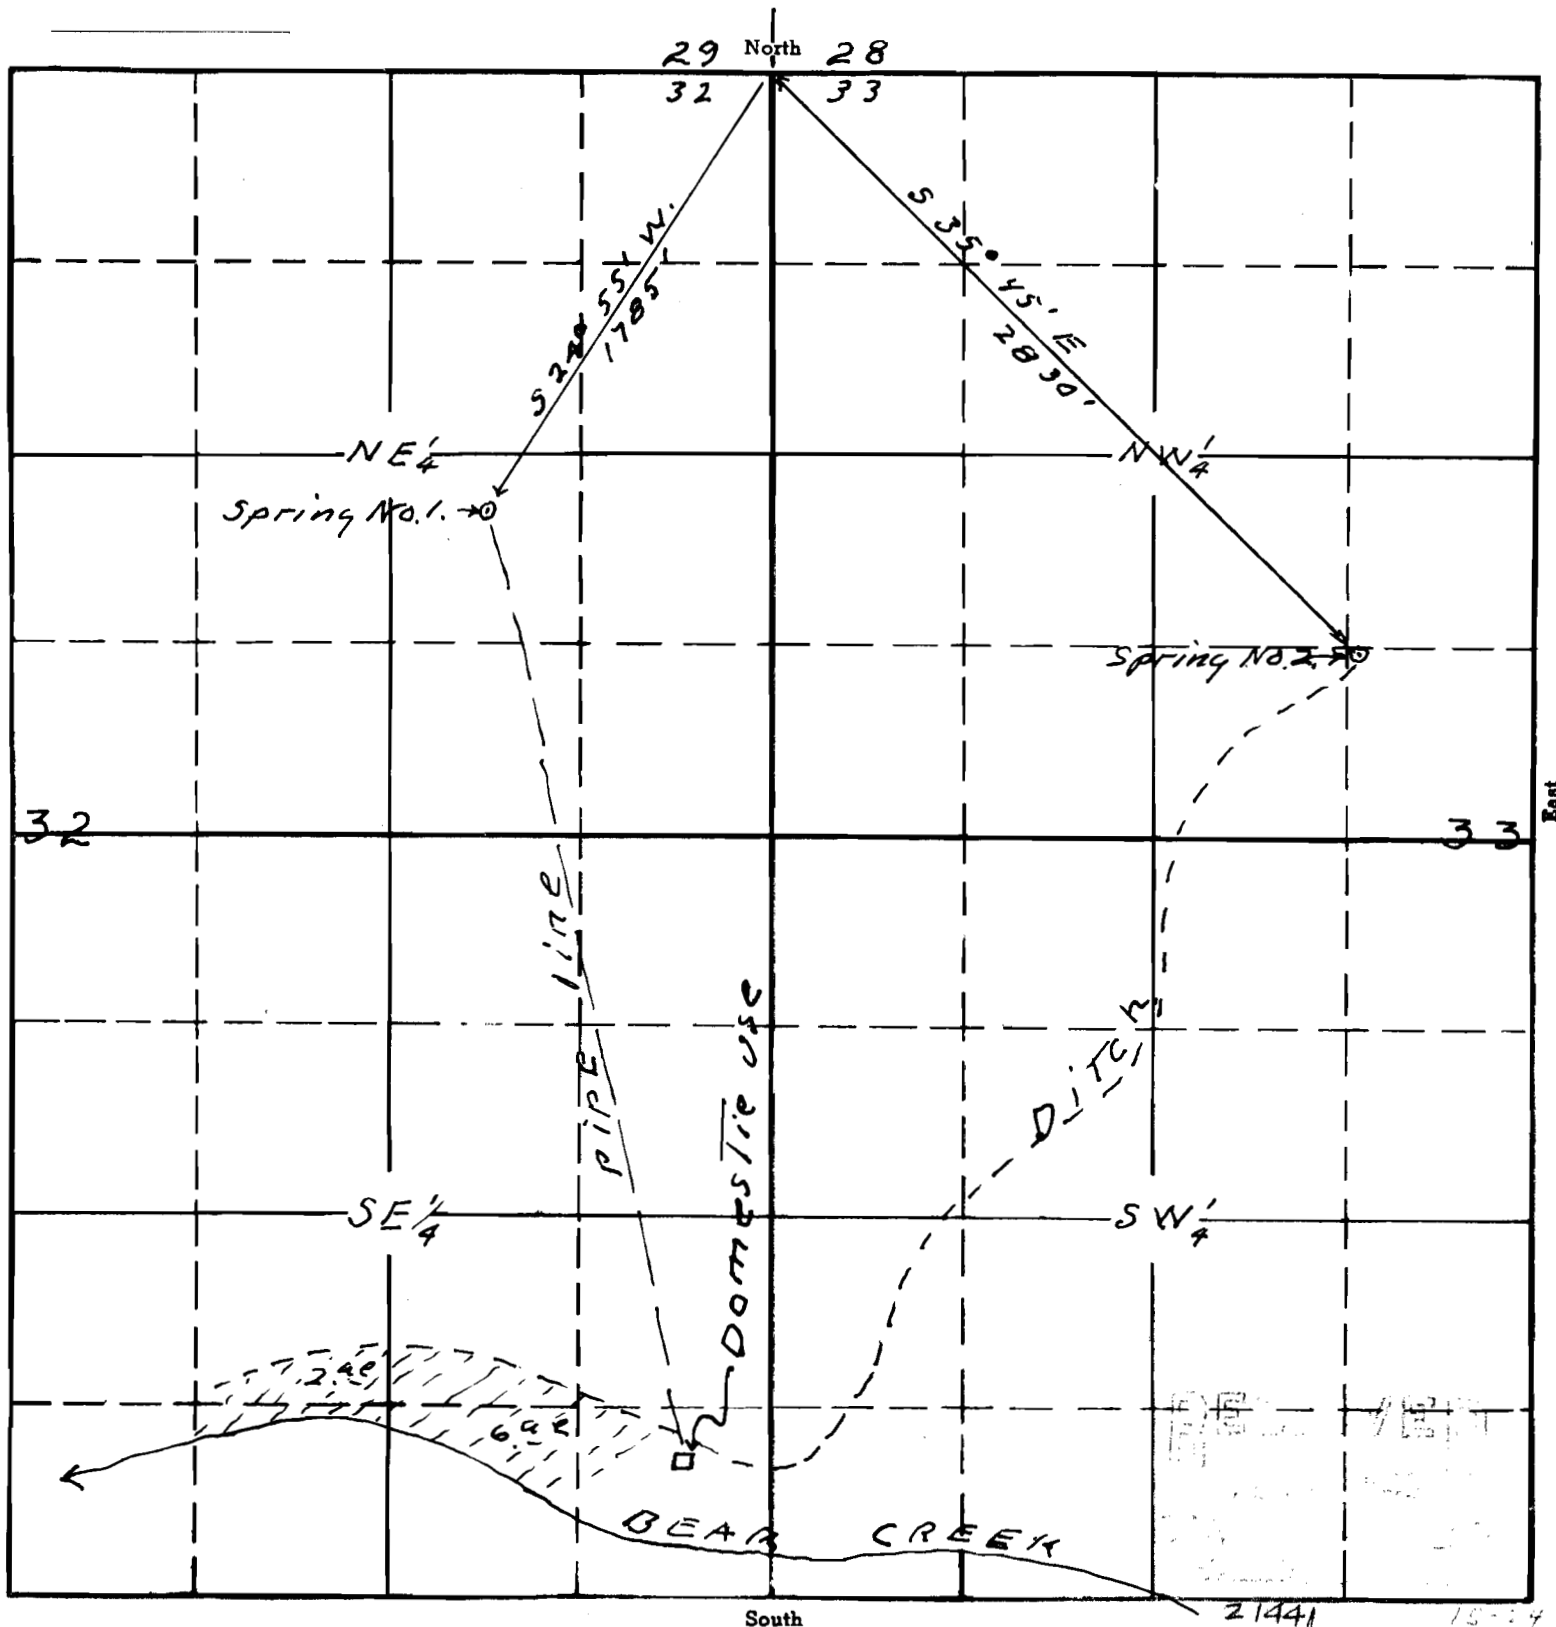

Application of W. P. Hamby for use of waters of No. 1 & No. 2 Springs for domestic and irrigation and stock purposes.

APPLICATION No. 21441  
PERMIT No. 16822

This office 2/20/46 W. Smith