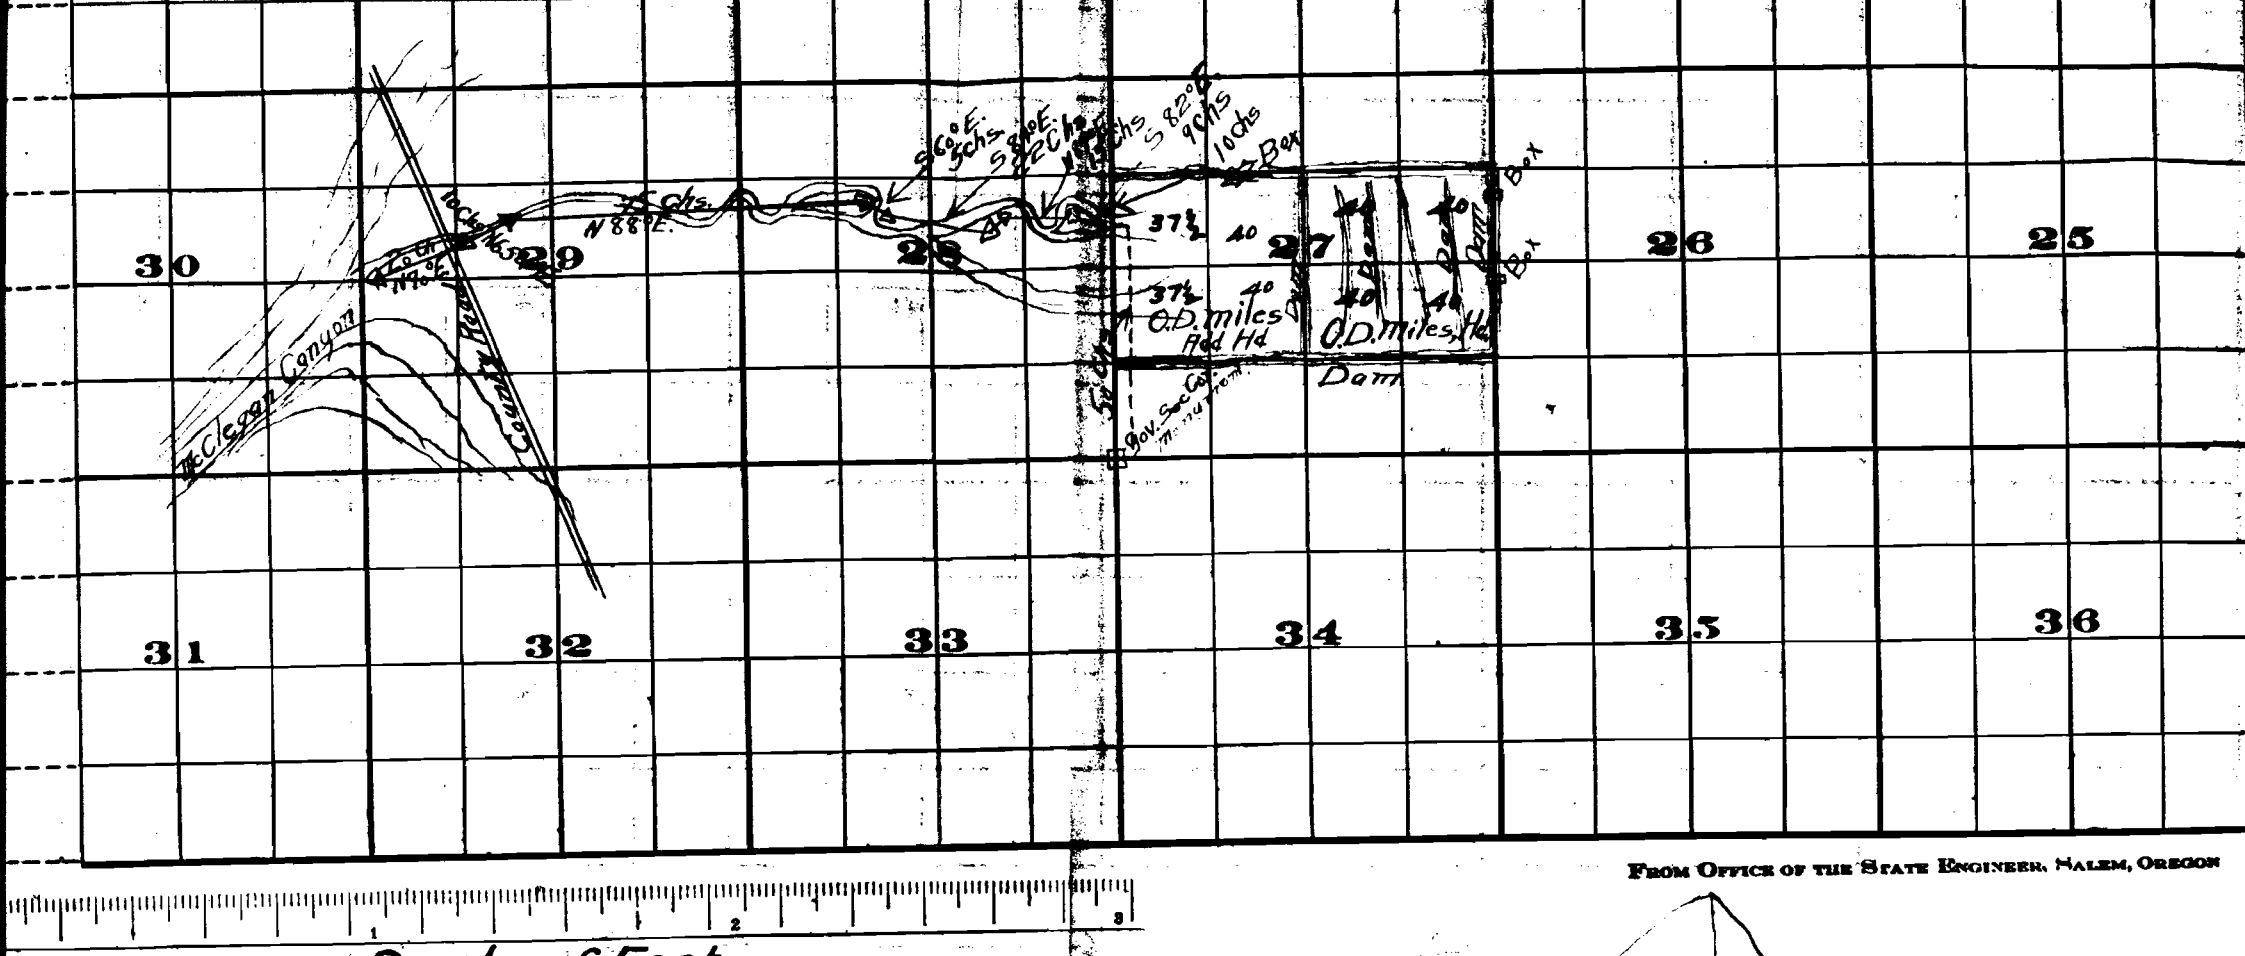

Scale of Feet.

T 20 S R 22 E

FROM OFFICE OF THE STATE ENGINEER, SALEM, OREGON

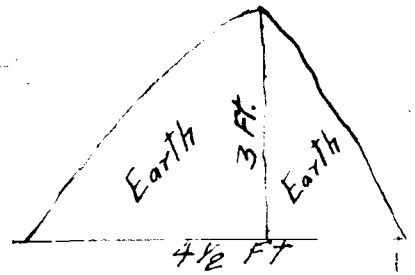

Cross Sec. of Dam

2117
1213