


PACIFIC OCEAN

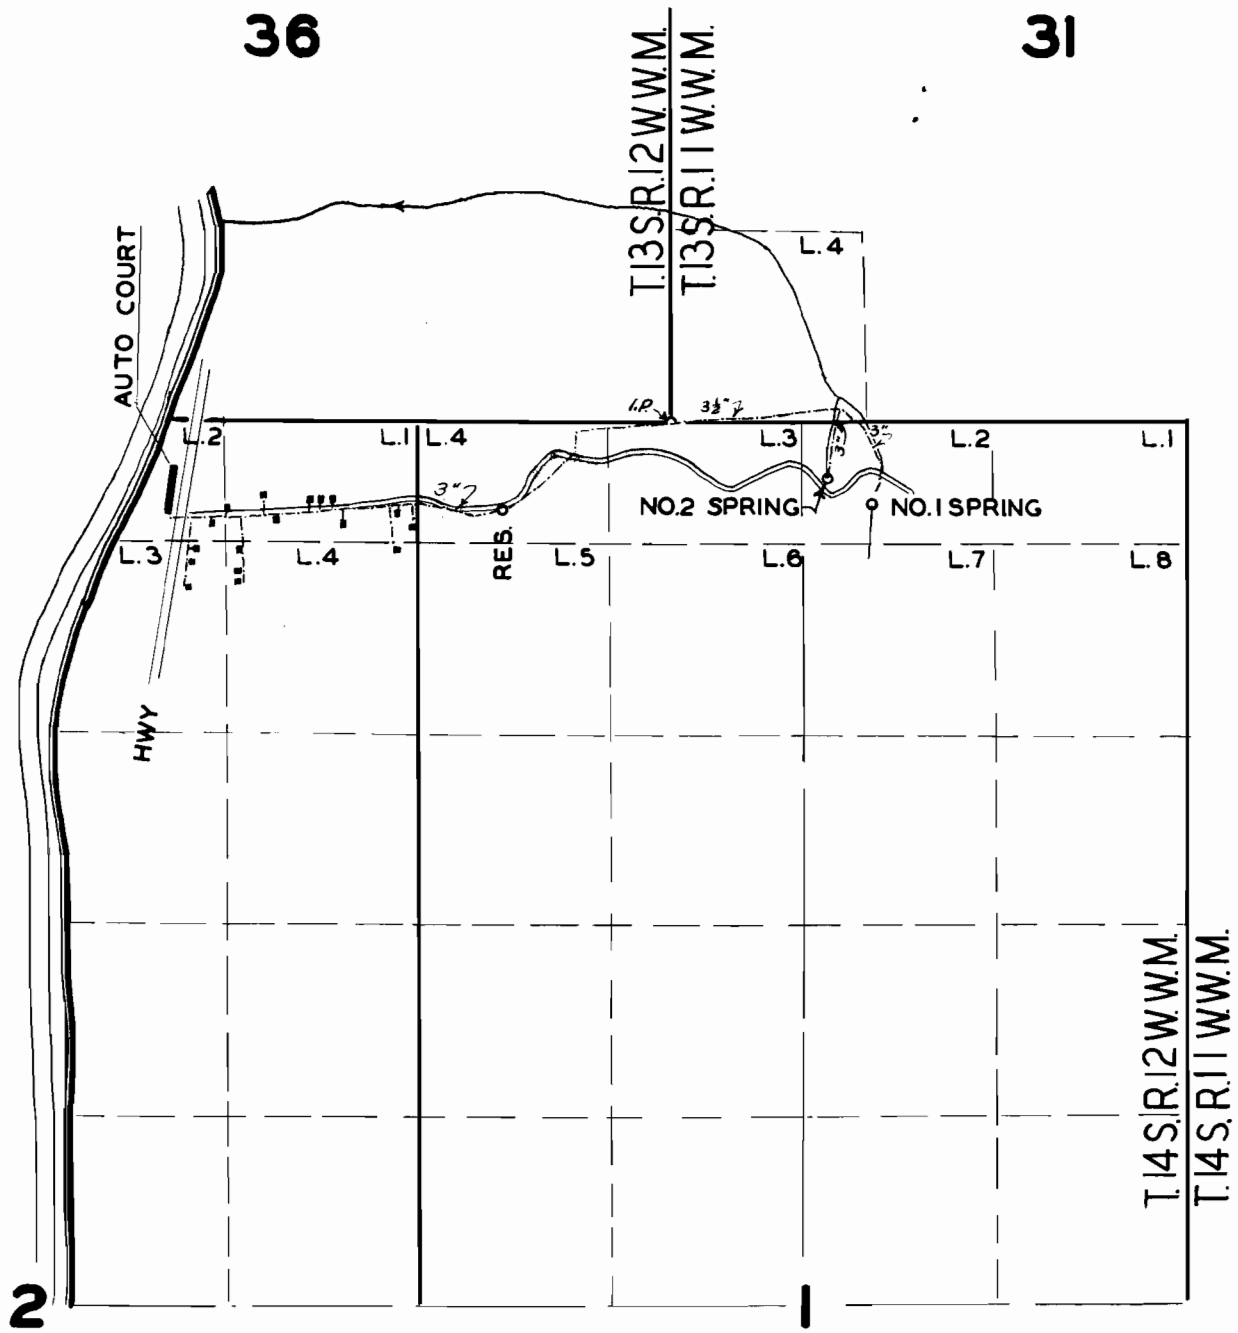

### FINAL PROOF SURVEY

UNDER

Application No. 19698... Permit No. 15277...  
IN NAME OF

JESSE C. PLANKINTON

Surveyed JUNE 9, 1950, by H.L. COFFMAN