


16

TOWNSHIP 37S, RANGE 1W, W. M.

North

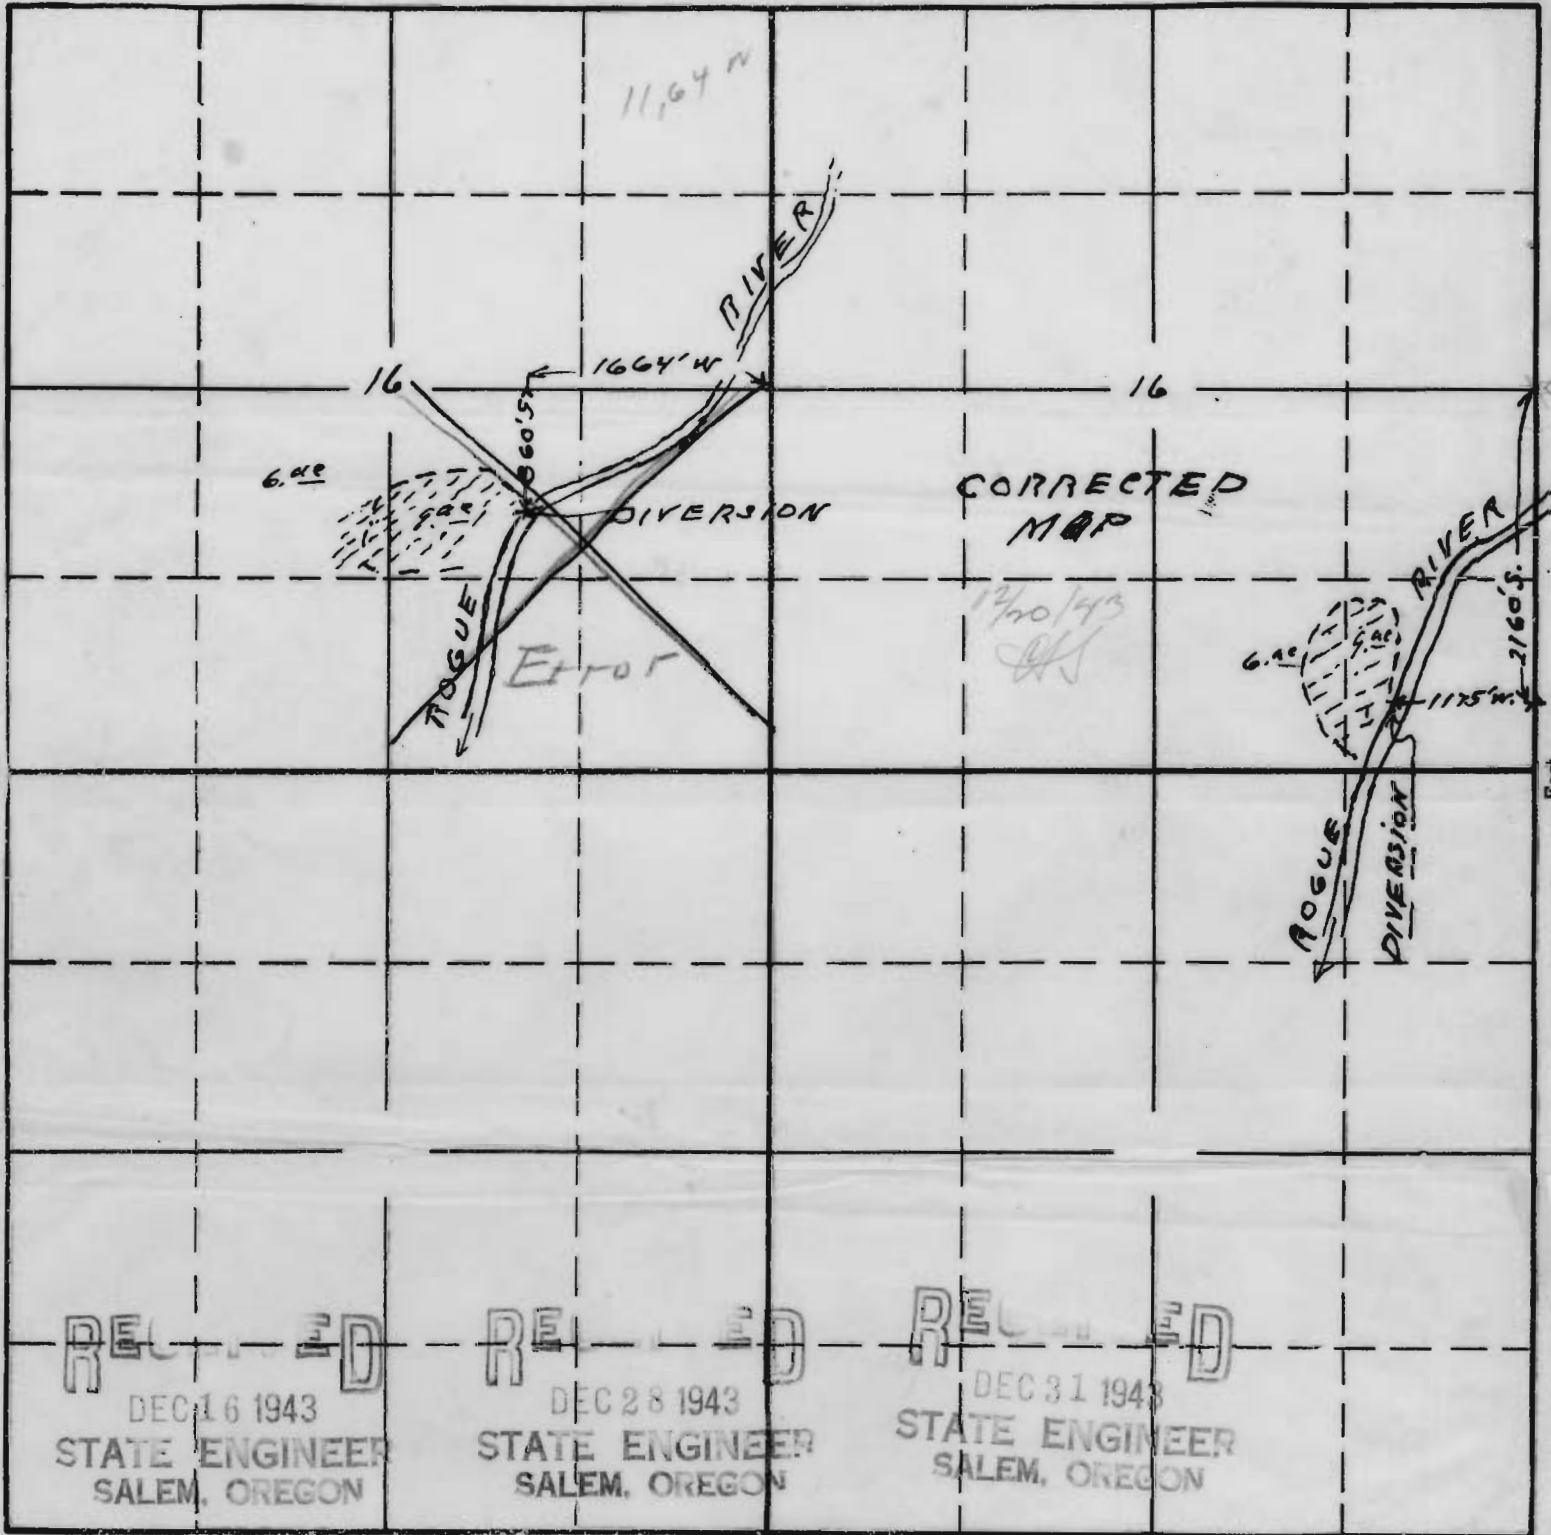

West

East

South

Map to accompany application of Wm E Stronbridge for use of waters of Rogue River for irrigation purposes

APPLICATION No. 20106
PERMIT No. 15664

This office 12/14/43 JLS