


T.25S.R.12 W.W.M.

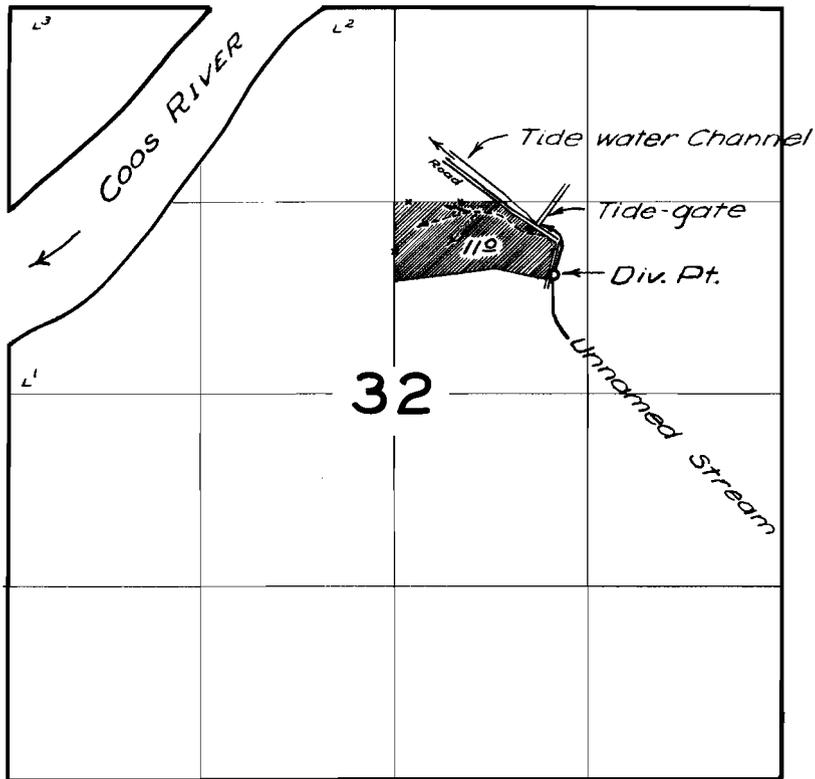

FINAL PROOF SURVEY
UNDER

Div. Pt. TRANSFER NO. C-106
Application No. 20276 Permit No. 15818
IN NAME OF

ALVIS E. CURL
July 15 1958 *m. Bish*
Surveyed June 3 1950, by *HL. Coffman*