


**T.15S. R.12W. W.M.**

PACIFIC OCEAN

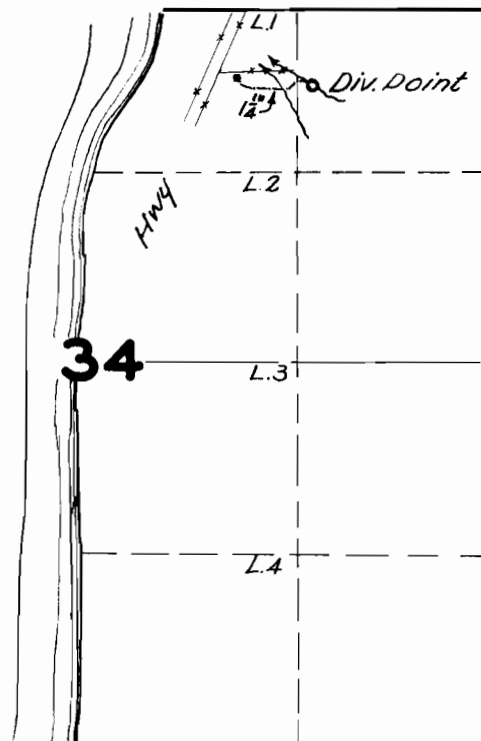

**FINAL PROOF SURVEY**

UNDER

Application No. **21118** Permit No. **16761**  
IN NAME OF

**A. E. BRAZEAU**

Surveyed JUNE 7, 1950, by H.L. COFFMAN