


T.15S.R.12W.W.M.

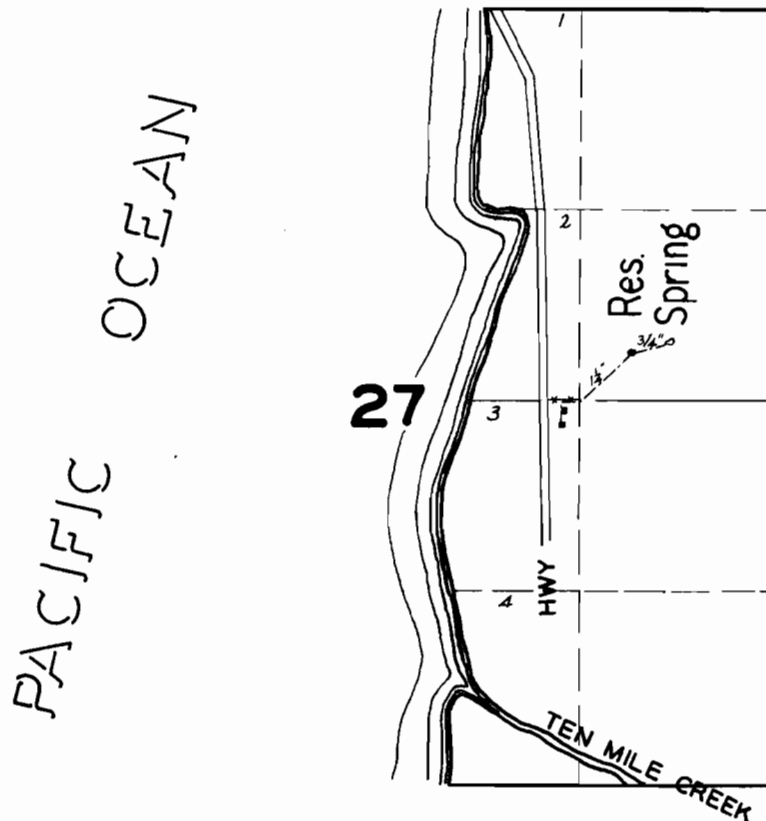

FINAL PROOF SURVEY

UNDER

Application No. **21429** Permit No. **16811**
IN NAME OF

E. A. WEBB

Surveyed JUNE 8 1950, by H.L. COFFMAN.