


T.16S. R.5 W.W.M

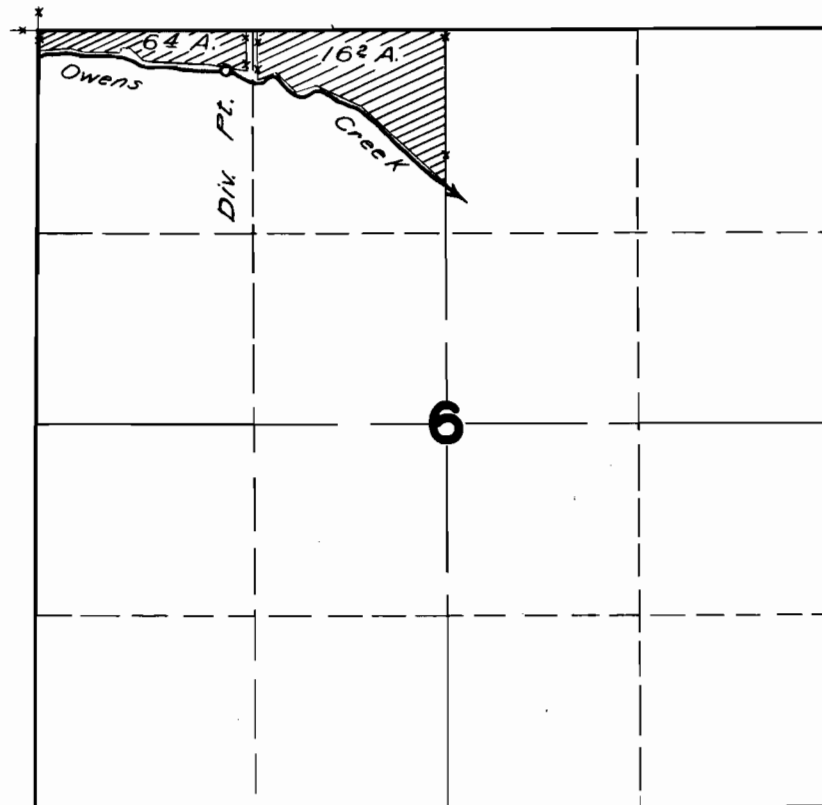

FINAL PROOF SURVEY

UNDER

Application No. **21529** Permit No. **16883**

IN NAME OF

C. J. MAHONEY

Surveyed **MAY 11, 1950**, by **H.L. COFFMAN**