


# T.29S.R.14W.W.M.

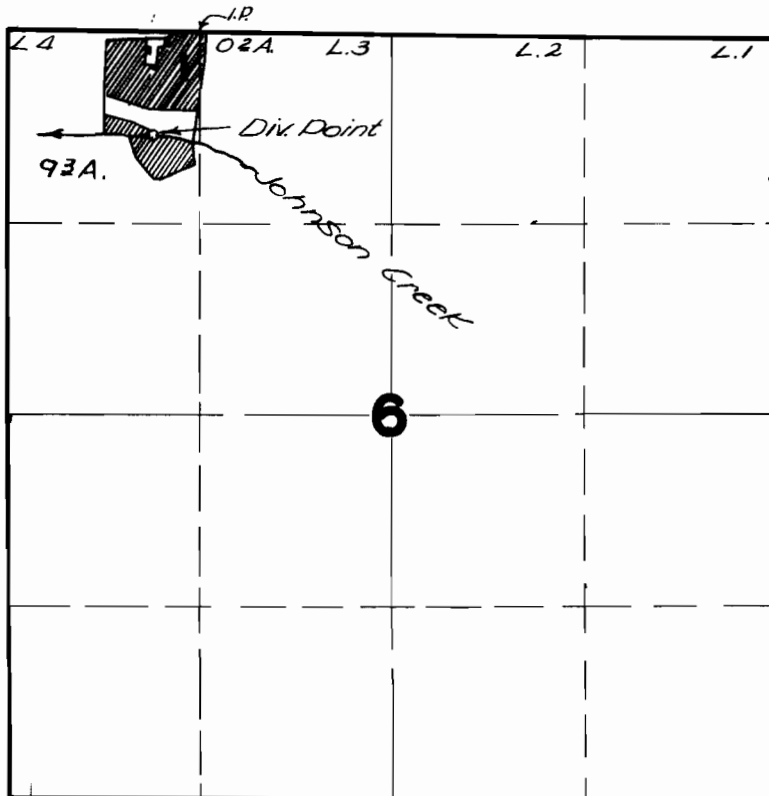

## FINAL PROOF SURVEY UNDER

Application No. 21958 Permit No. 17347  
IN NAME OF

A. W. KAPING & PEARL C. KAPING

Surveyed JUNE 2, 1950, by H.L. COFFMAN