


T.15S.R.12W.W.M.

PACIFIC OCEAN

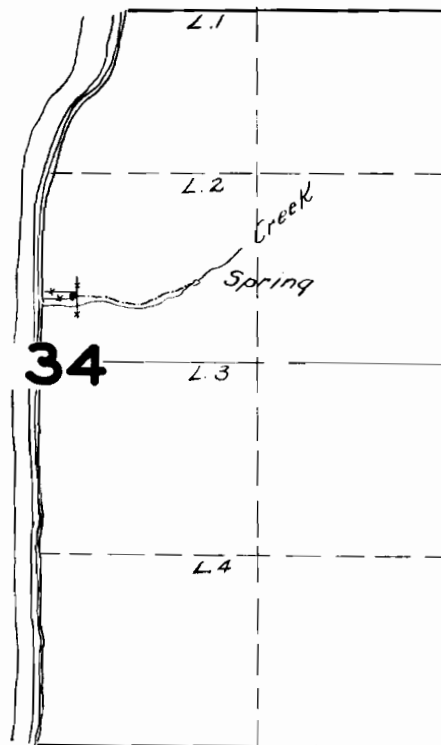

FINAL PROOF SURVEY
UNDER

Application No. **21986** Permit No. **17522**
IN NAME OF

CHARLES E. JARRETT

Surveyed **JUNE 7 1950**, by **H.L. COFFMAN**