


**T.2S. R. 2E. W.M.**

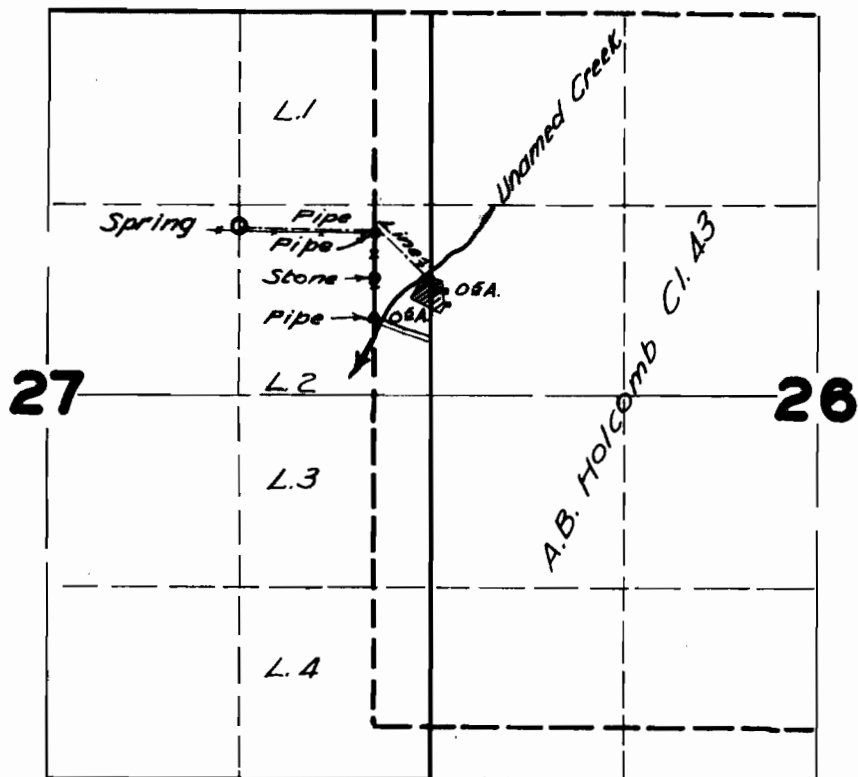

**FINAL PROOF SURVEY**

UNDER

Application No. ~~23696~~ Permit No. ~~18716~~

IN NAME OF

CHESTER P. BURNS

Surveyed APR. 28 1950., by H. L. COFFMAN