


T.3N. R.10E. W.M.

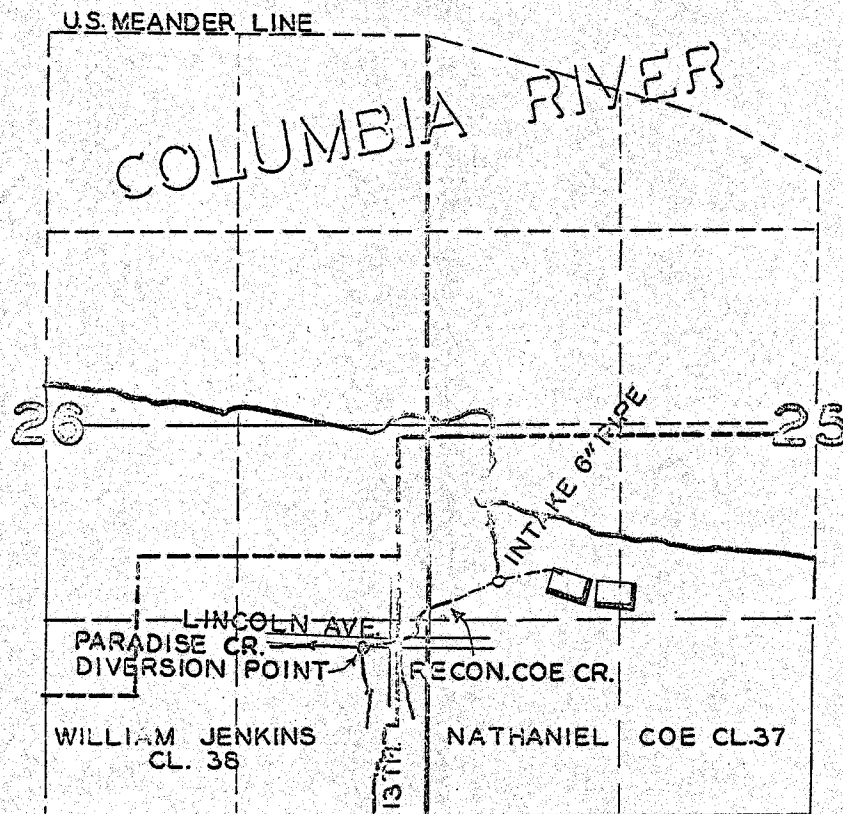

FINAL PROOF SURVEY
UNDER

Application No. 21764. Permit No. 17120.

IN NAME OF

DUCKWALL BROTHERS, INC.

Surveyed JUNE 14 1950, by H.L. COFFMAN