


T.21S.R.4W.W.M.

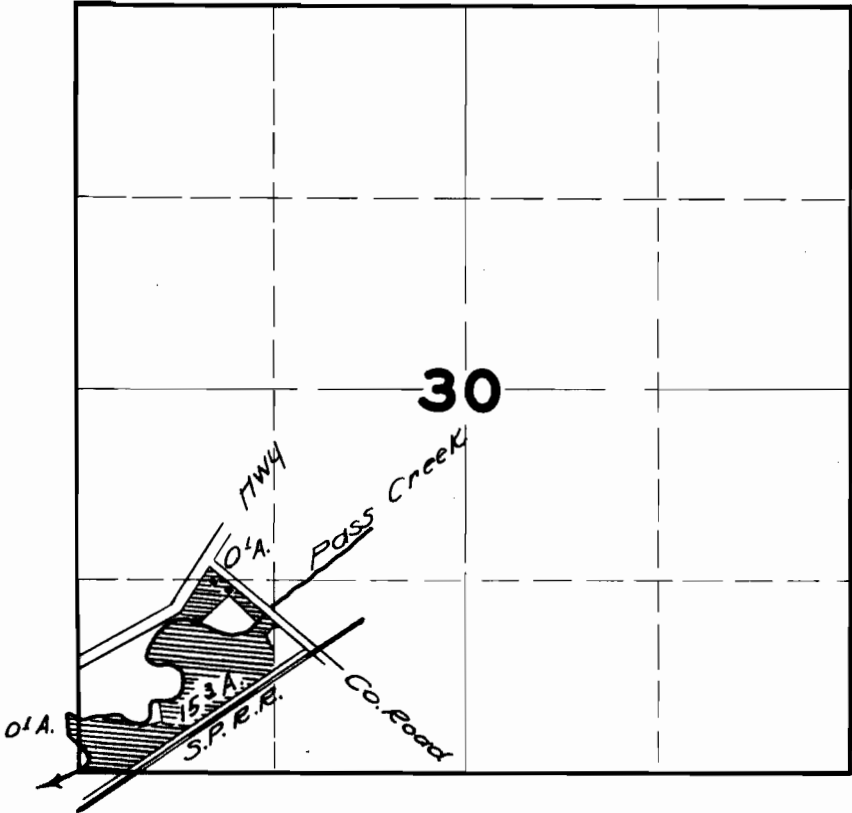

FINAL PROOF SURVEY
UNDER

Application No. 21795... Permit No. 17148...
IN NAME OF

.....E. E. GALLATIN.....

Surveyed MAY 16, 1950, by H.L. COFFMAN