


T.30S.R.4W.W.M.

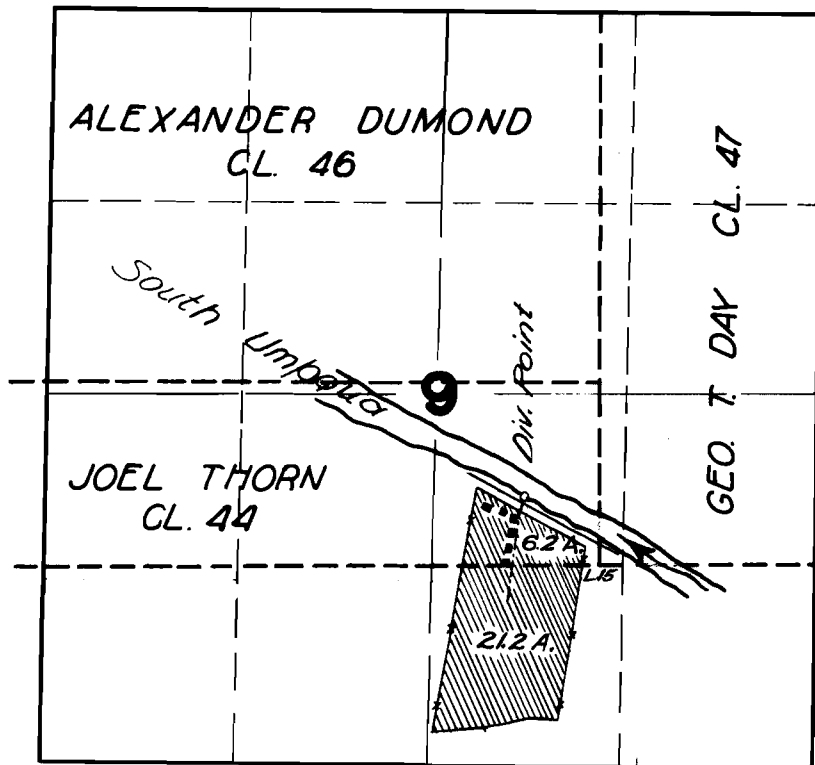

FINAL PROOF SURVEY UNDER

Application No. 22171... Permit No. 17459...
IN NAME OF

JACK & SYLVIA GAULKE

Surveyed MAY 23 1950., by H.L. COFFMAN...