


T.30S.R.4W.W.M.

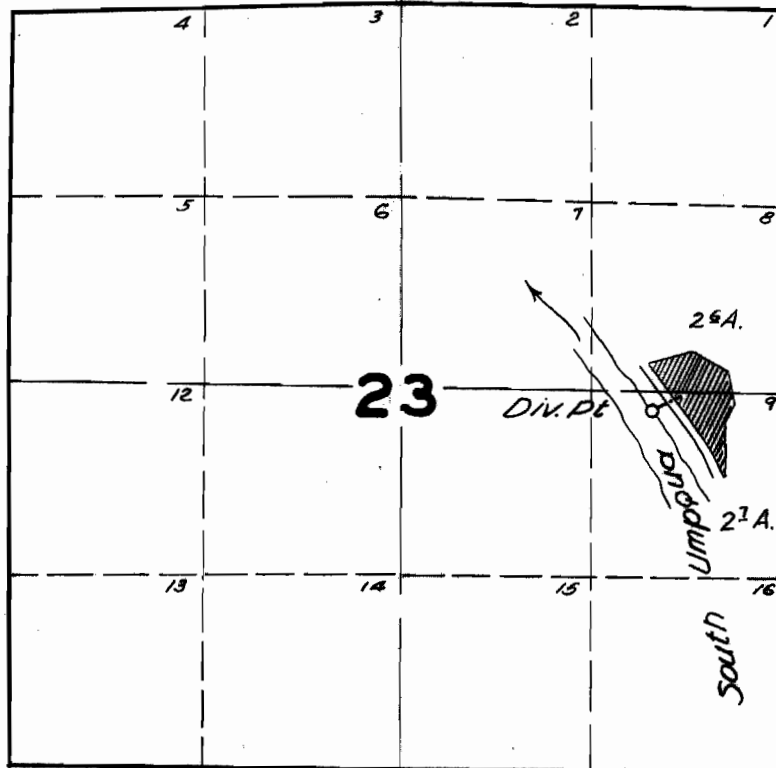

FINAL PROOF SURVEY

UNDER

Application No. 225⁷⁶ Permit No. 17767

IN NAME OF

.....LAURIN MACEWAN.....

Surveyed MAY 23, 1950., by H.L. COFFMAN.