


T. 3N.R. 10E.W.M.

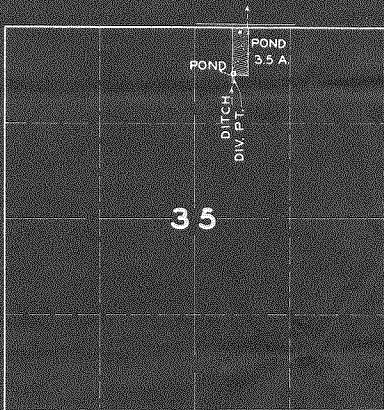

FINAL PROOF SURVEY
UNDER

Application No. 22583 Permit No. 17772
IN NAME OF

S. C. WOODY

Surveyed JUNE 13 1950, by H. L. COFFMAN