


# T.30S.R.2 W.W.M.

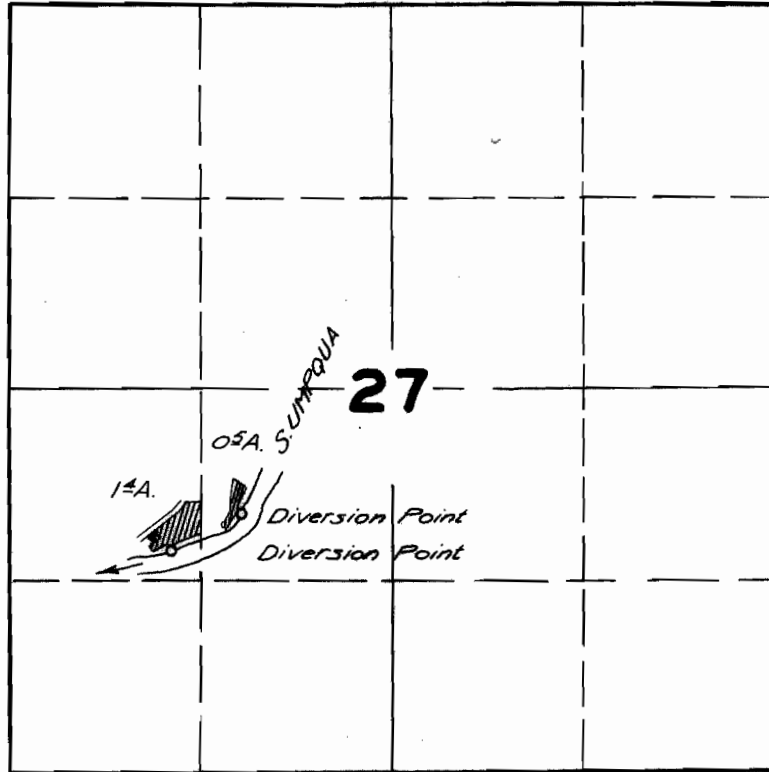

## FINAL PROOF SURVEY

UNDER

Application No. 22585. Permit No. 17774.....

IN NAME OF

KING L. HEISKELL.....

Surveyed MAY. 22. 1950., by H.L. COFFMAN