


**T.28S.R.14W.W.M.**

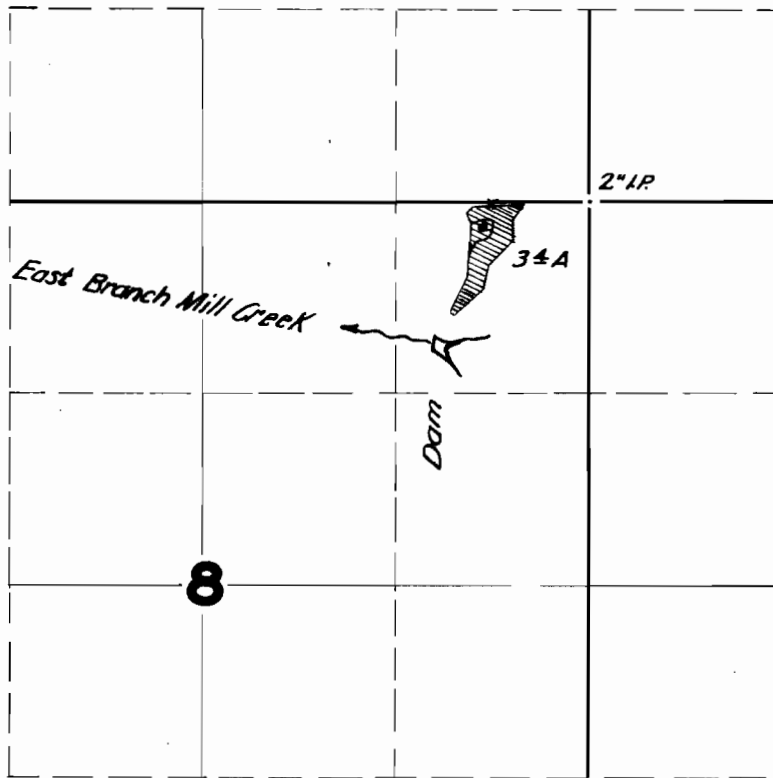

**FINAL PROOF SURVEY**

UNDER

Application No. **22918**. Permit No. **18008**.

IN NAME OF

**HOWARD HULL**

Surveyed **JUNE 4 1950**, by **H.L. COFFMAN**.