


T. 4N. R. 2W. W.M.

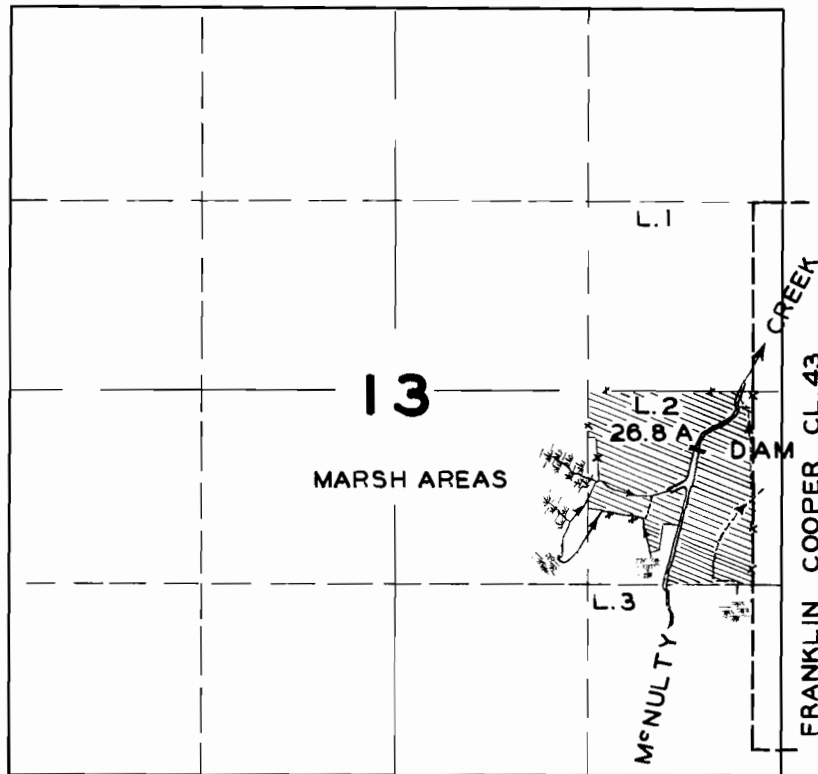

FINAL PROOF SURVEY UNDER

Application No 23382 Permit No 18458
IN NAME OF

JOHN E. JOHNSON

Surveyed AUG. 8 1950, by H. L. COFFMAN.