


T.15S.R.12 W.W.M.

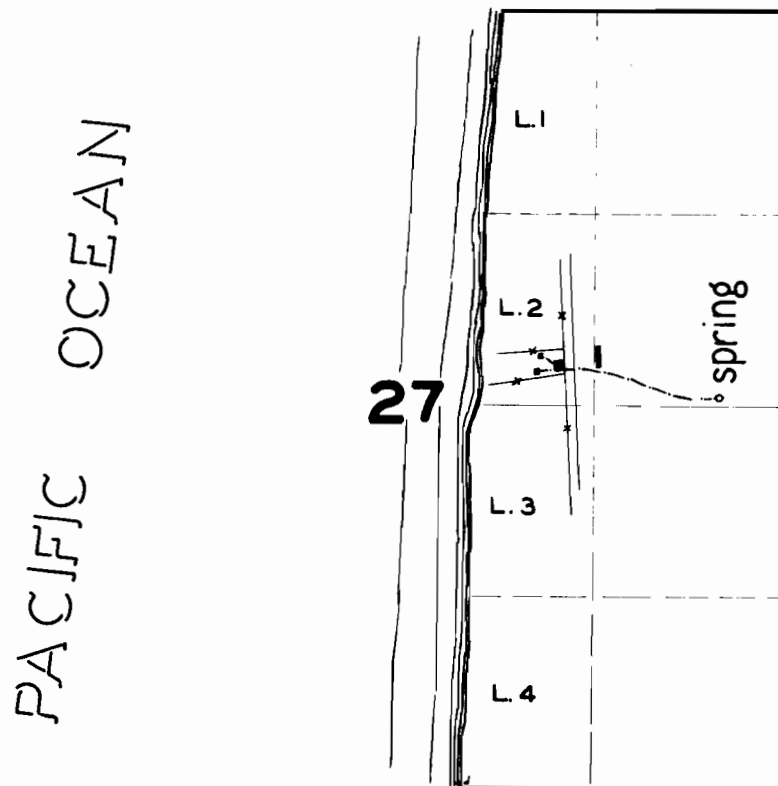

FINAL PROOF SURVEY

UNDER

Application No. **22192** Permit No. **17534**
IN NAME OF

IRA E. RAY & L. S. RICHARDSON

Surveyed JUNE 6, 1950, by H.L. COFFMAN.