


T.4N.R.10W.W.M.

PACIFIC OCEAN

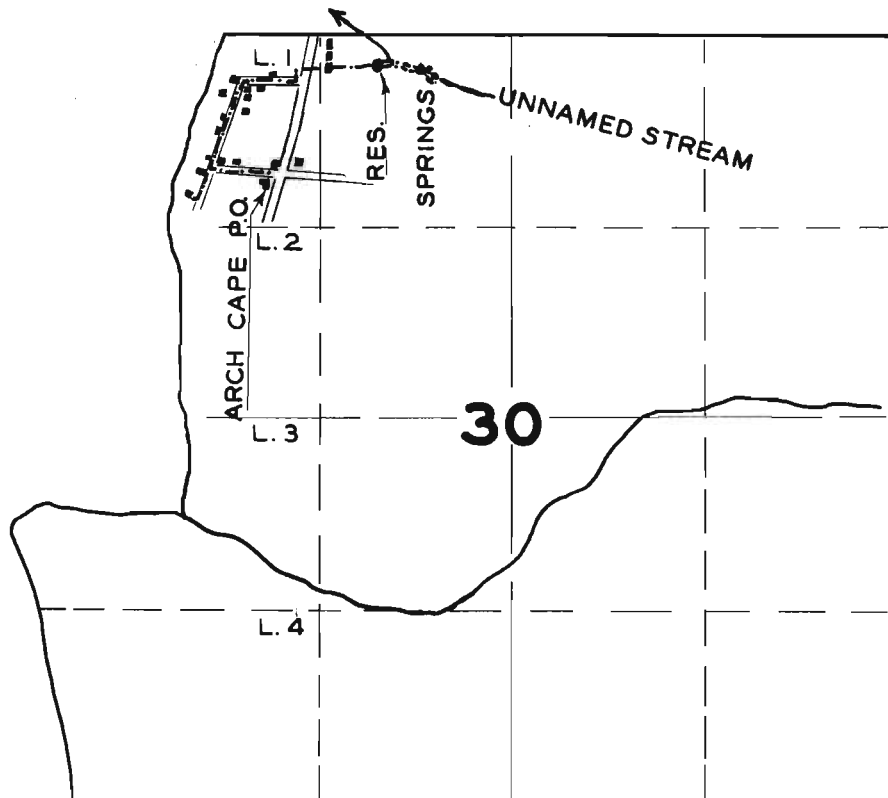

FINAL PROOF SURVEY

UNDER

Application No. 14548. Permit No. 10685.
IN NAME OF

E. C. & AILEEN WHITE

Surveyed JULY 18 1950, by H.L. COFFMAN.