


13590
17887

T. IN. R. 15 E. W. M.

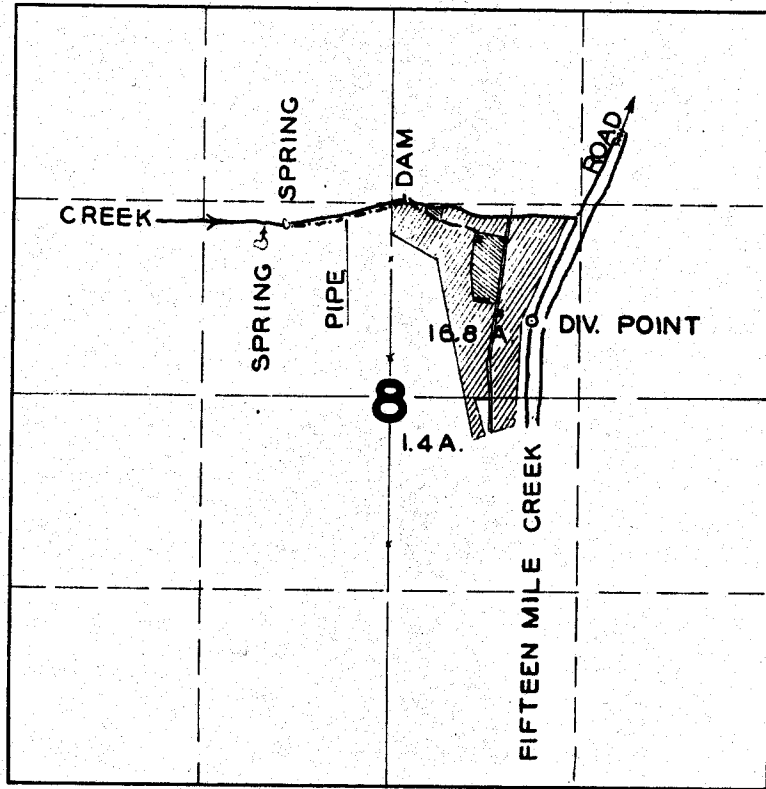

PERMIT 13590

PERMIT 17887



2.2 A. UNNUMBERED CR



18.2 A. 15 MILE SOURCE

FINAL PROOF SURVEY

UNDER

17903

13590

Application No. 22675 Permit No. 17887

IN NAME OF

GEORGE WAGENBLAST

Surveyed JUNE 27 1950, by H.L. COFFMAN.