


T.28S.R.12W.W.M.

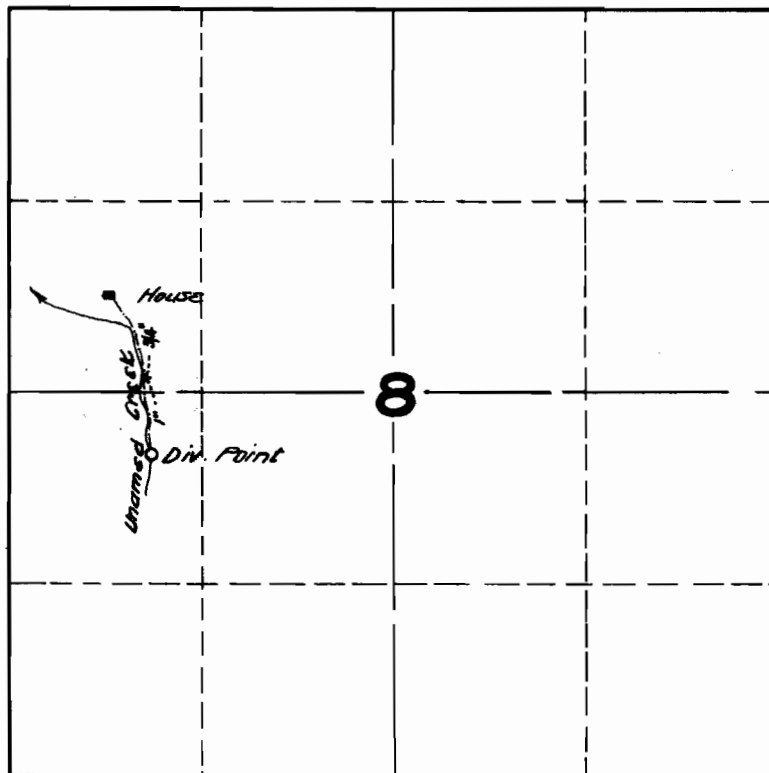

FINAL PROOF SURVEY

UNDER

Application No. **18252**... Permit No. **13908**...

IN NAME OF

H.S. & BEULAH NORTON

Surveyed **SEPT. 16 1949**, by **H.L. COFFMAN**.